


T. 15S., R. 5W., W.M.

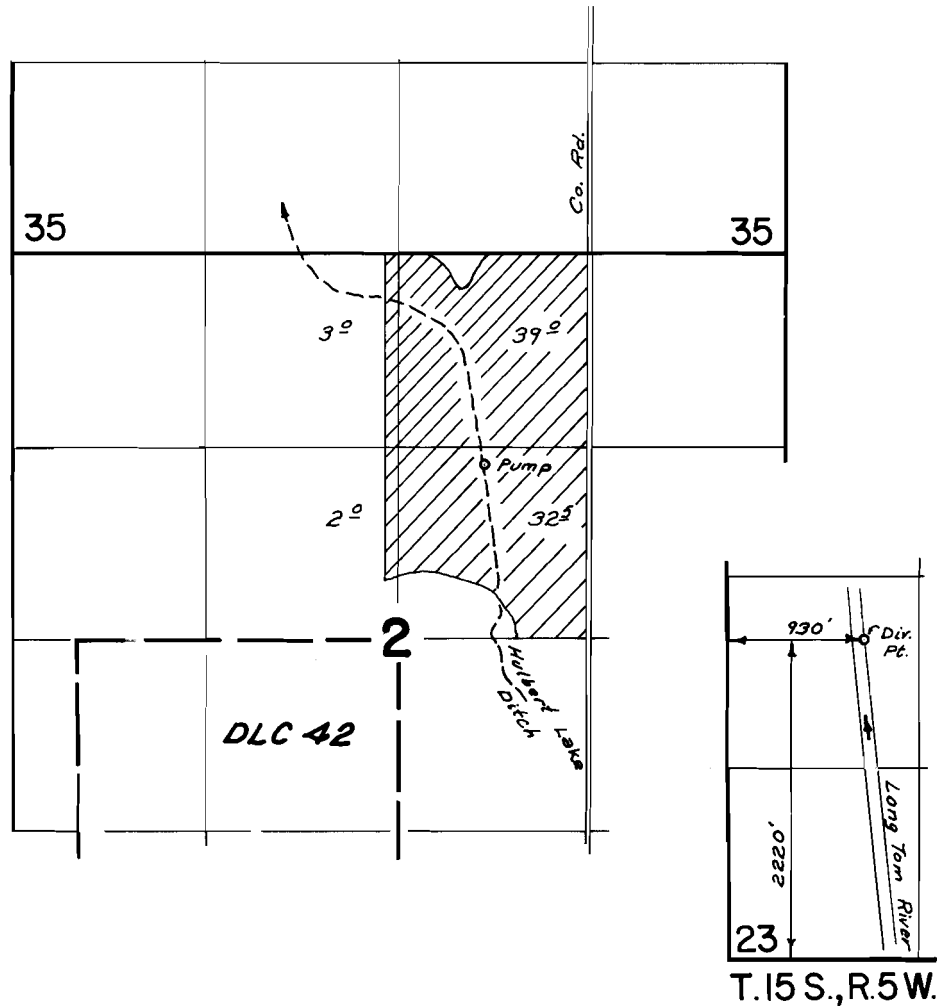

FINAL PROOF SURVEY
UNDER

Application No. 44569 Permit No. 33360
IN NAME OF

Vera Hubbard

Surveyed May 11, 1976, by D.M. Norby