


T.20S. R.3W. W.M.

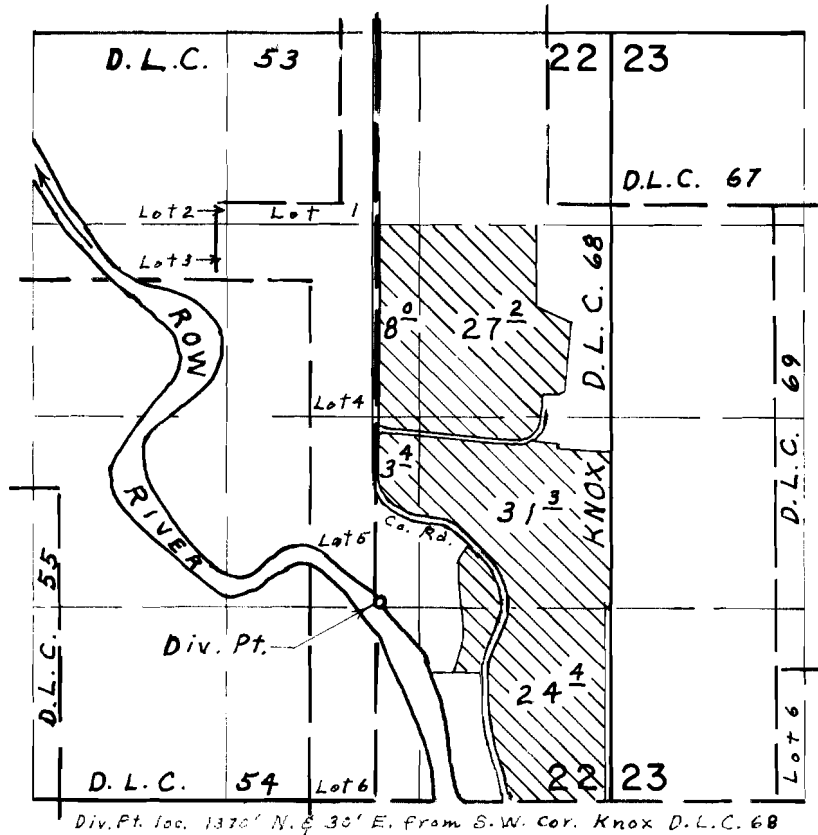

FINAL PROOF SURVEY UNDER

Application No. 45/24 ... Permit No. 33683
 IN NAME OF

GEORGE MOLITOR

Surveyed March 27 1975, by L. E. Gould