


I, DAVID J. NEW OF WALLA WALLA, WASHINGTON,  
 DO HEREBY CERTIFY THAT THIS MAP WAS MADE FROM  
 NOTES TAKEN DURING AN ACTUAL SURVEY MADE  
 UNDER MY IMMEDIATE SUPERVISION ON MAY 18, 1957.

*David J. New*

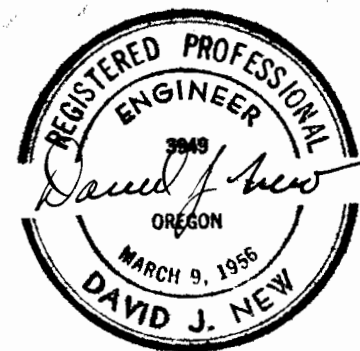

# SILETZ TRACT

**ROBIN REED TRACT**  
 SEC. 13 TWP. 8S., R. 11 W. 1/4 M.  
 LINCOLN COUNTY, OREGON.  
 SCALE: 1" = 100'  
 DRAWN: L.E.F. CHECKED: D.J.N.

Application No. R-31494 & 31495  
 Permit No. R-2035 & 24958