


T.14&15 S. R.39 E. W.M.

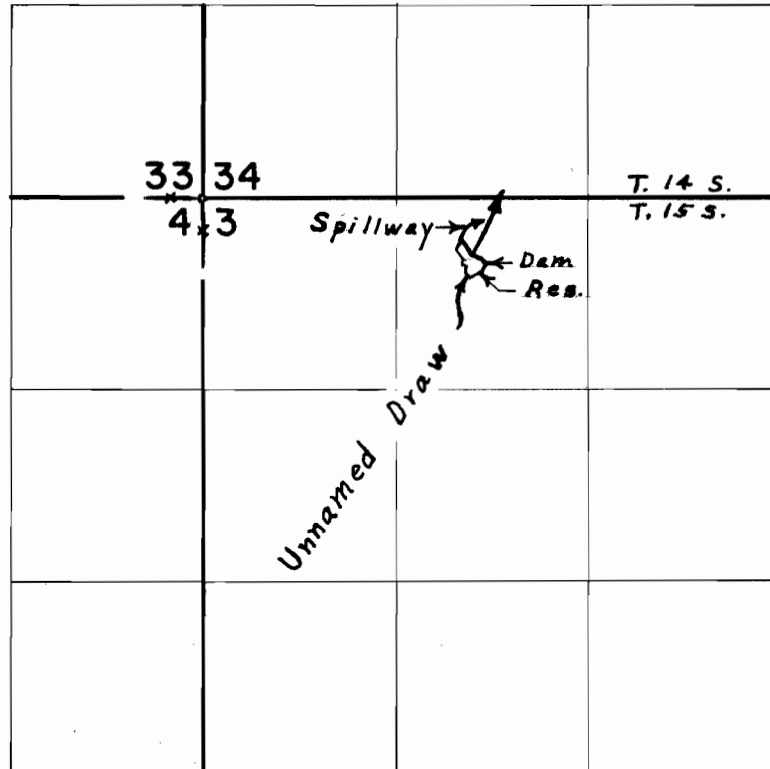

FINAL PROOF SURVEY
UNDER

Application No. R-43216 Permit No. R-4948
IN NAME OF

RAY DUNCAN

Surveyed April 23, 1975, by L. E. Gould