


T.14 & 15 S. R.39 E. W.M.

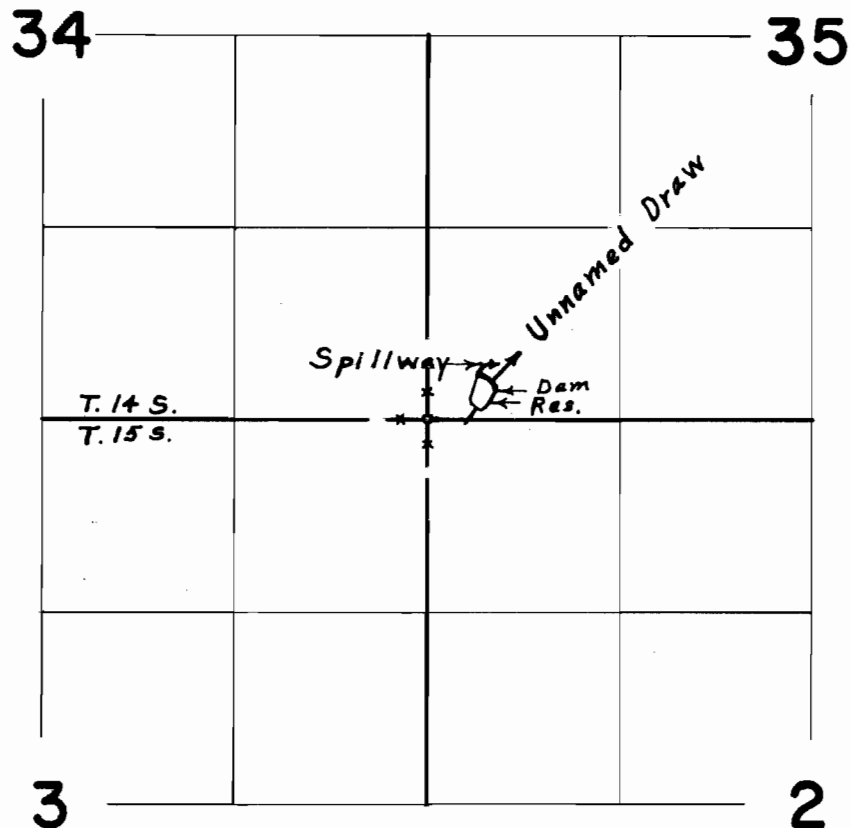

**FINAL PROOF SURVEY**  
UNDER

Application No. R-432.17 Permit No. R-4249  
IN NAME OF

RAY DUNCAN

Surveyed April 23, 1975, by L. E. Gend.