


T.17S., R.47E., W.M.

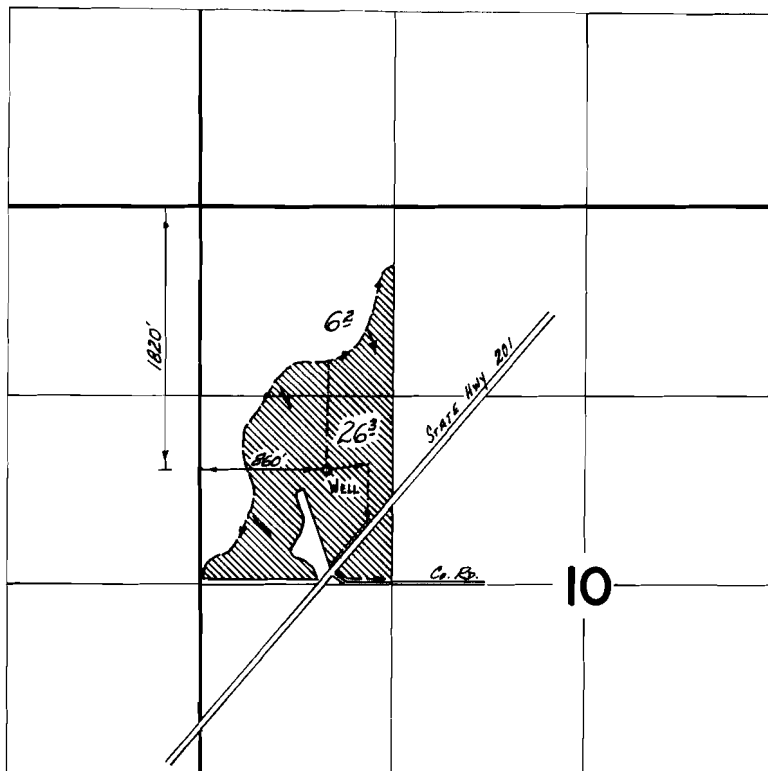

**FINAL PROOF SURVEY**  
UNDER

Application No. G-3013 Permit No. G-3054  
IN NAME OF

RALPH DEWEY

Surveyed May 26 1973, by D. NORBY