


T.14S. R.39E. W.M.

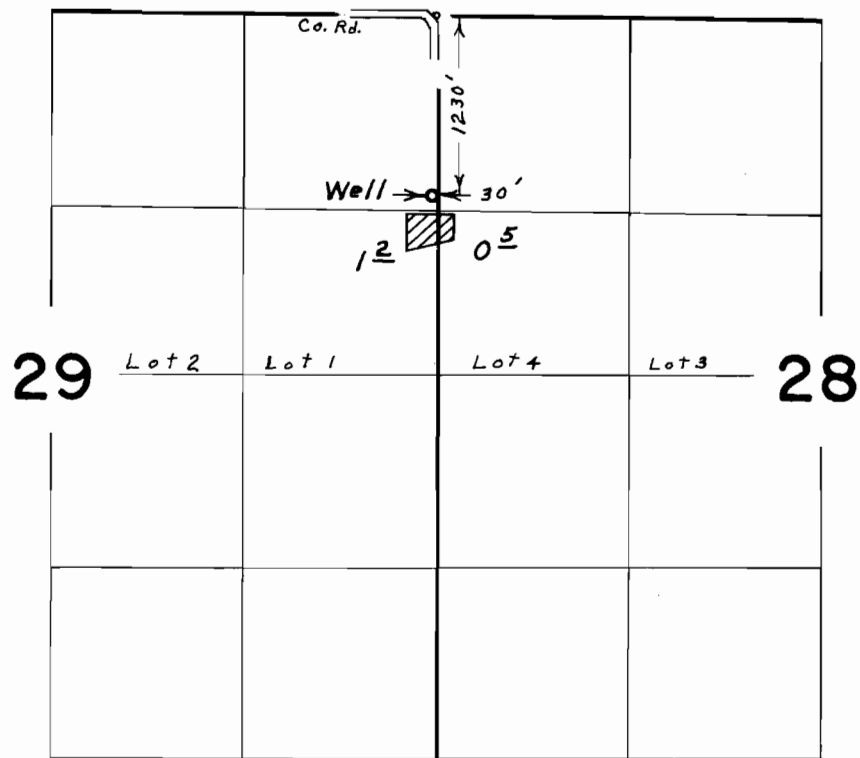

FINAL PROOF SURVEY
UNDER

Application No. G-3975 Permit No. G-3732
IN NAME OF

IRONSIDE CEMETERY DISTRICT

Surveyed April 22, 1975, by L. E. Gould