


T. 6 S. R. 1 E. W. M.

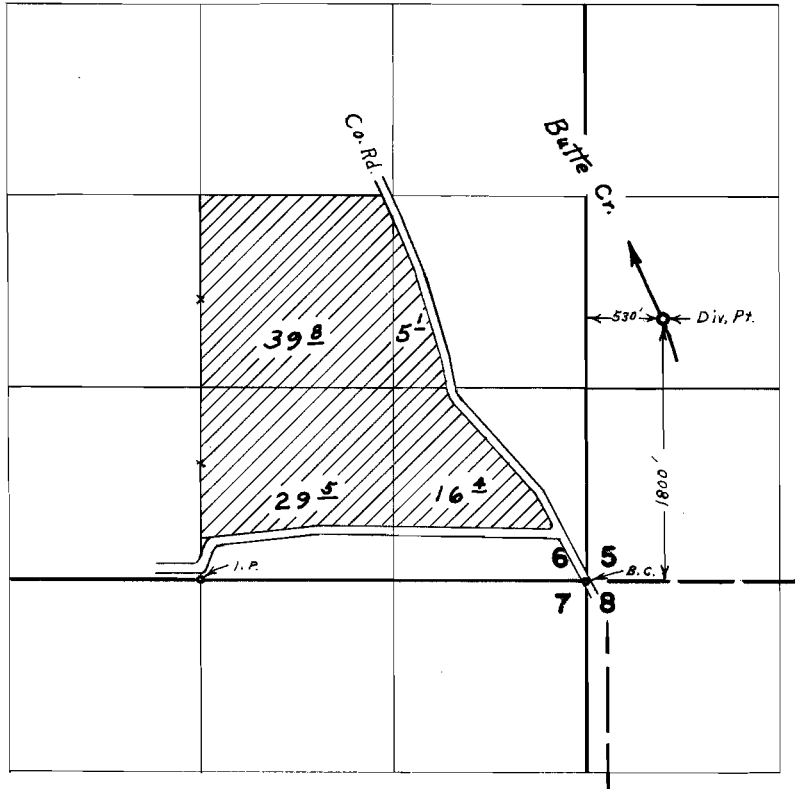

Note: 60 Acres allowed under P. 23008 C. 24551

FINAL PROOF SURVEY UNDER

Application No. 43764 Permit No. 32150
IN NAME OF

GEORGE G. WHITE

Surveyed May 7, 1968, by L. E. Gould