


T.9S.,R.2W.,W.M.

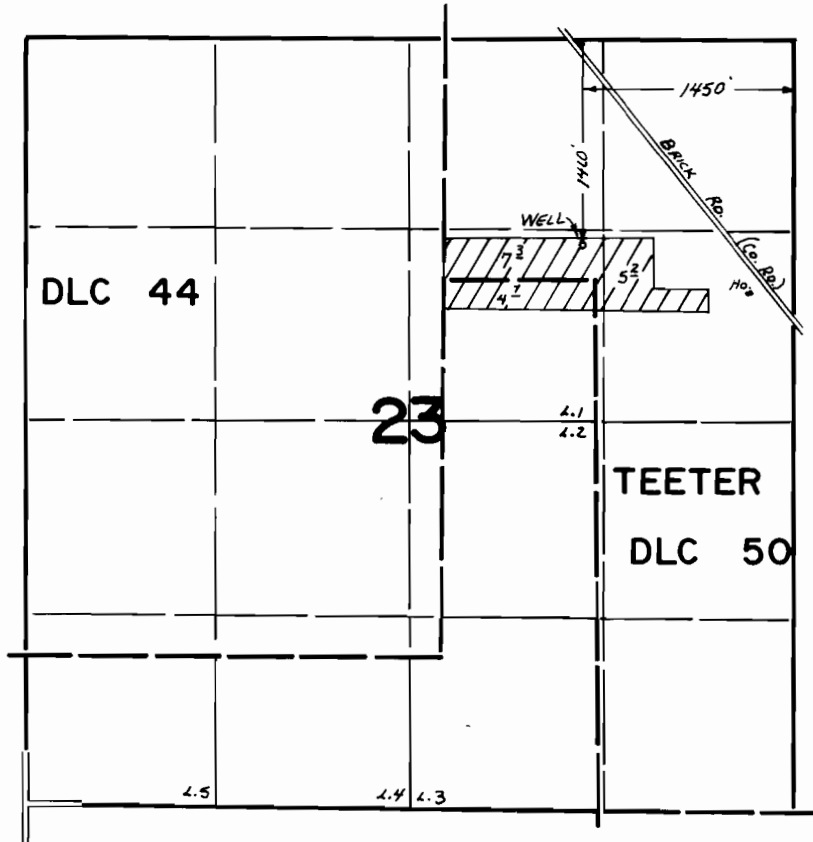

**FINAL PROOF SURVEY**  
UNDER

Application No. G-5466 Permit No. G-5376  
IN NAME OF

PETER P. THRELKEL

Surveyed July 8, 1976, by L. TOLL