


G-4361
444217

T.1S.R.24E.W.M.

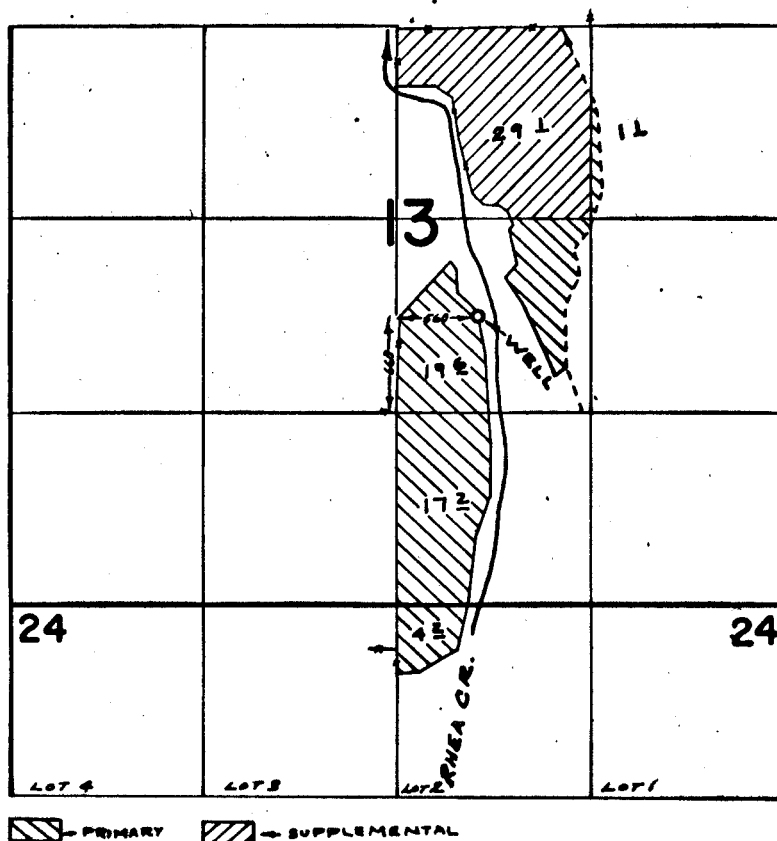

FINAL PROOF SURVEY UNDER

Application No. G-4437 Permit No. G-4361
IN NAME OF

MARION LEE PALMER

Surveyed May 13, 1921, by R. MUCKEN