


T. 1 N. R. 2 E. W. M.

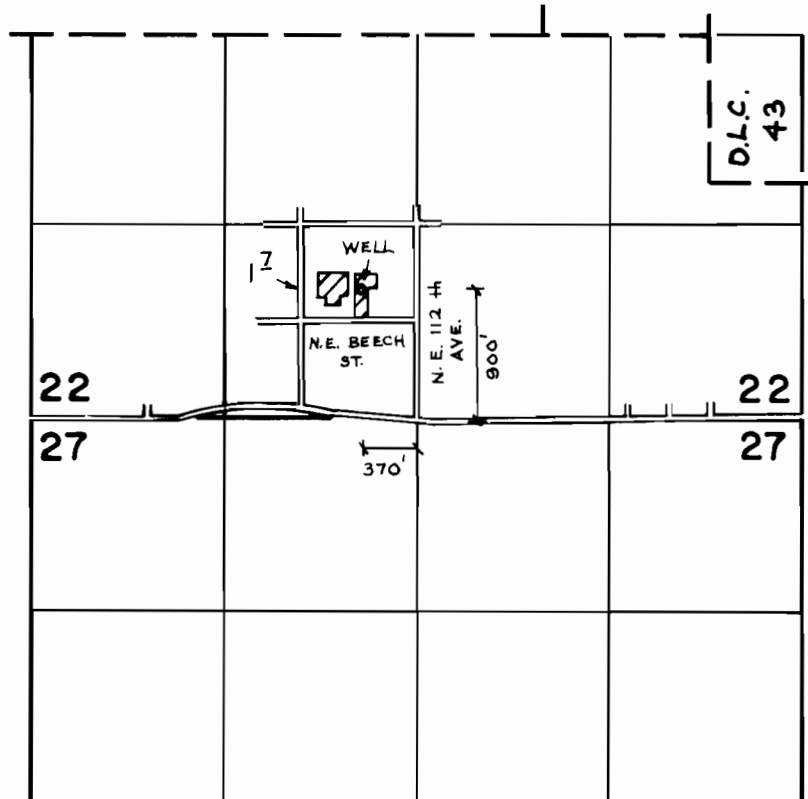

FINAL PROOF SURVEY UNDER

Application No. G-4923 Permit No. G-4639
IN NAME OF

LOUIS A. HOPWOOD

Surveyed July 8, 1976, by R.G. Mucken