


T.3N.,R.10W.,W.M.

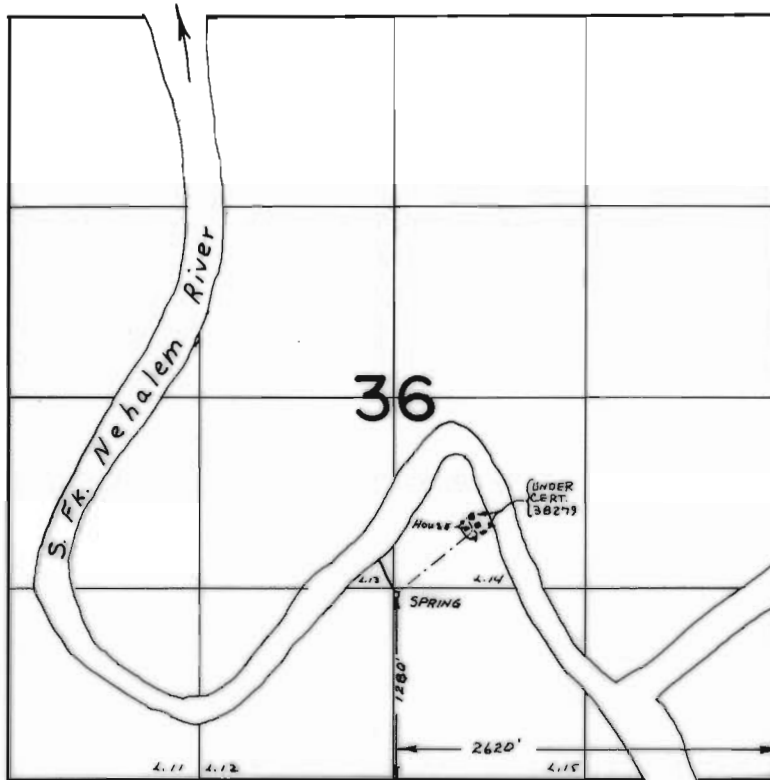

FINAL PROOF SURVEY
UNDER

Application No. 49453 Permit No. 36096
IN NAME OF

ELMER STURM

Surveyed JUNE 24 1975, by L. E. GOULD