


T.1S.,R.8W.,W.M.

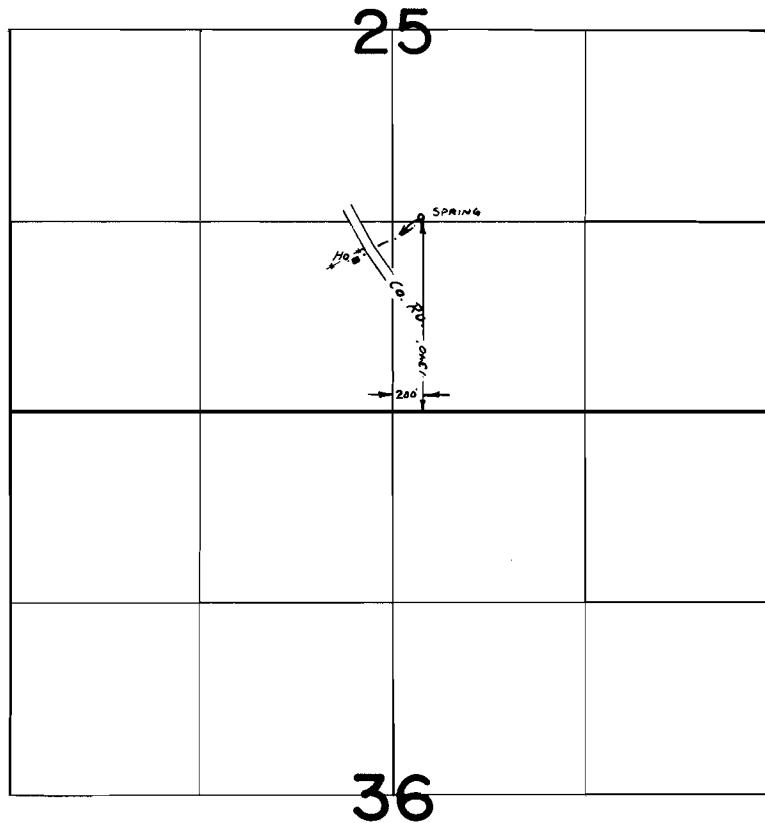

FINAL PROOF SURVEY
UNDER

Application No. 49984 Permit No. 37594
IN NAME OF

RICHARD GENTRY

Surveyed JUNE 25 1975, by L. E. GOULD