


T. 4 S. R. 5 W. W.M.

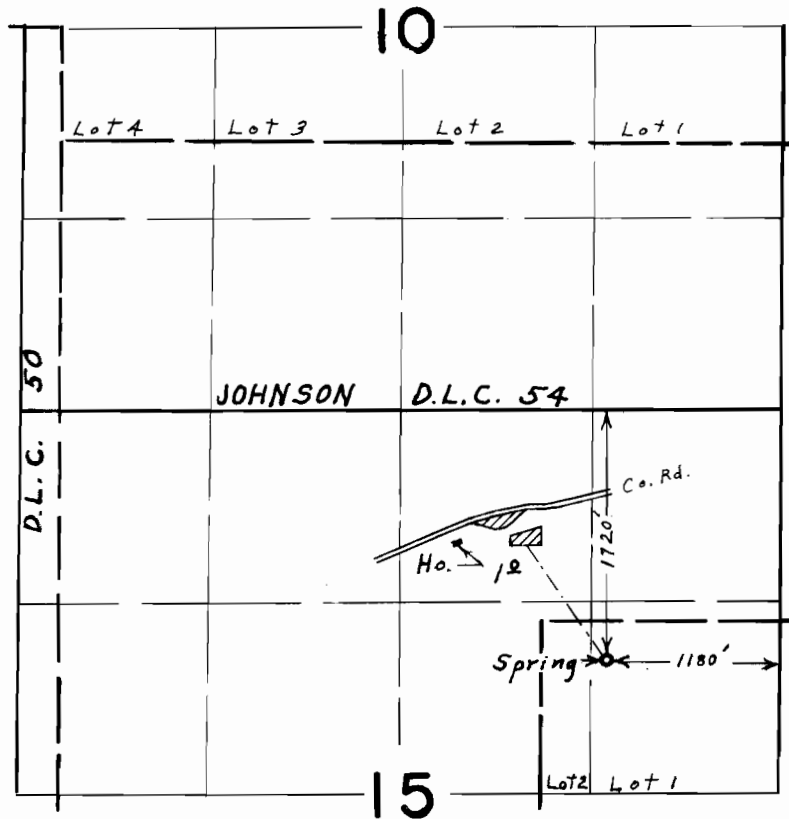

**FINAL PROOF SURVEY**  
UNDER

Application No. 42877 Permit No. 32045  
IN NAME OF

JOHN WAUGAMAN

Surveyed April 18, 1975 by L. E. Gould