


T.5 S. R.5 W. W.M.

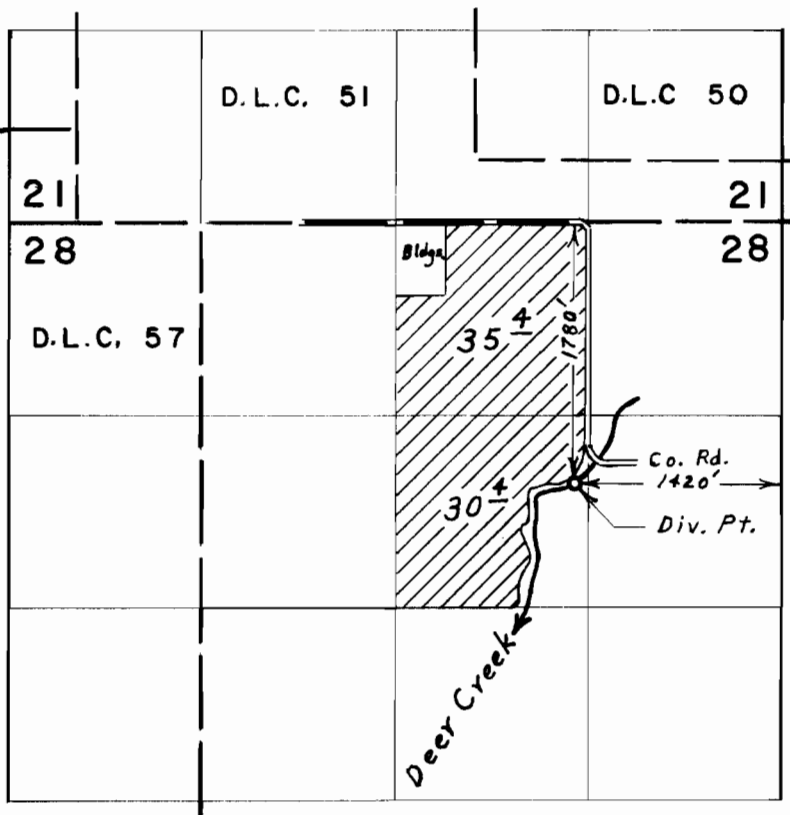

FINAL PROOF SURVEY UNDER

Application No. 46615 Permit No. 34891
IN NAME OF

CHESTER STRINGER, JR.

Surveyed Sept. 3, 1975, by L. E. Gould