


T.5 S. R.3 W. W.M.

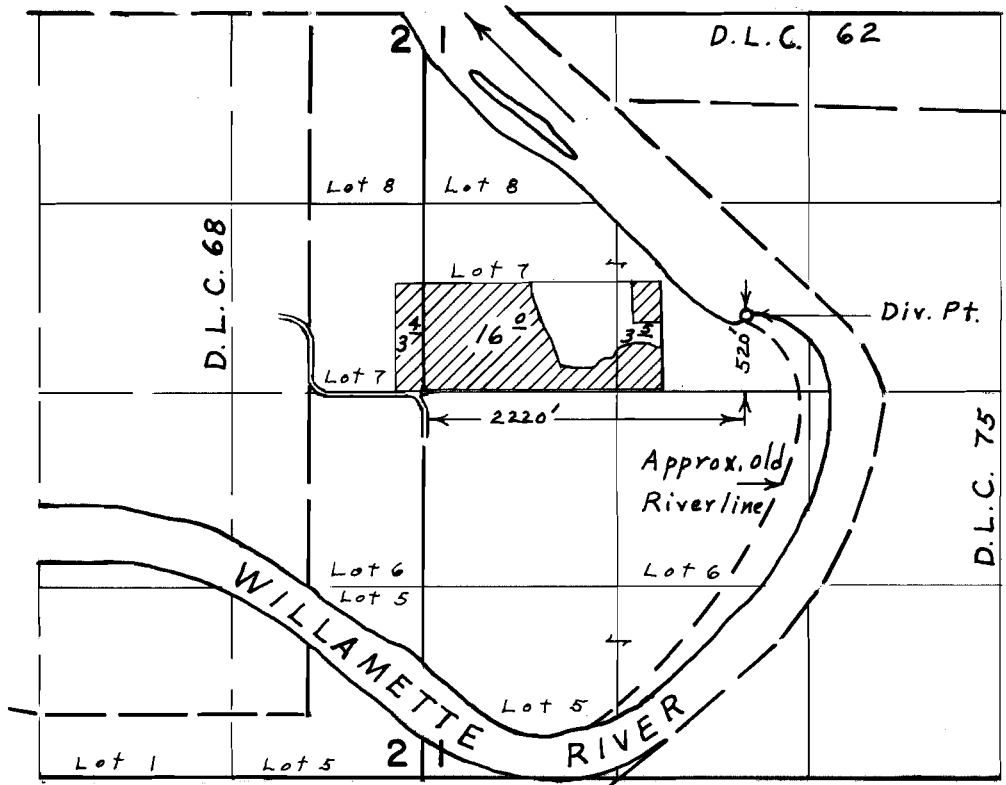

FINAL PROOF SURVEY
UNDER

Application No. 48219 Permit No. 35500
IN NAME OF

CHARLES & DOROTHY L. BRYAN

Surveyed April 14, 1975, by L. E. Gould