


T.2 S. R.5 W. W.M.:

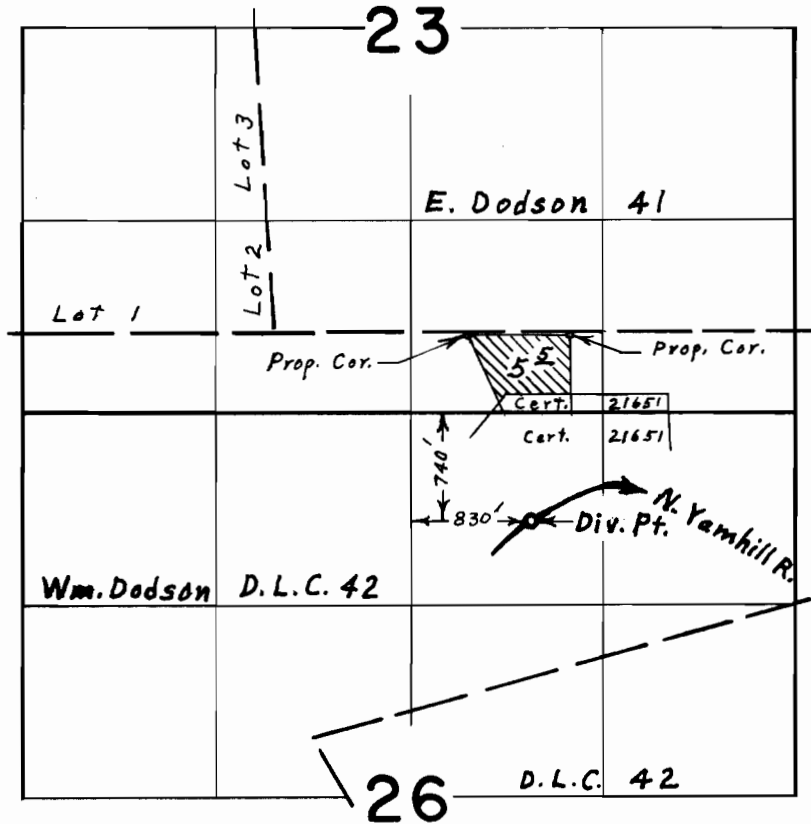

FINAL PROOF SURVEY
UNDER

Application No. 50290 Permit No. 36796
IN NAME OF

LINDA M. TAYLOR

Surveyed Sept. 5, 1975, by L. E. Gauld.