


T. 2 S. R. 3 W. W. M.

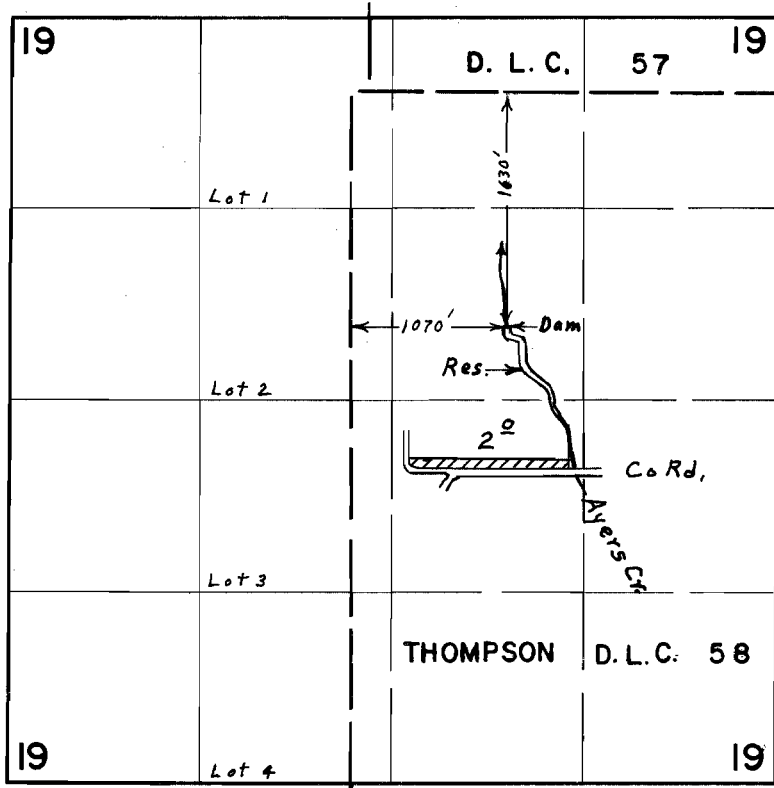

FINAL PROOF SURVEY UNDER

Application No. 49810 Permit No. 37469
IN NAME OF

EUGENE OBERG

Surveyed July 29, 1975, by L. E. Gould