


T.3 S. R.4 W. W.M.

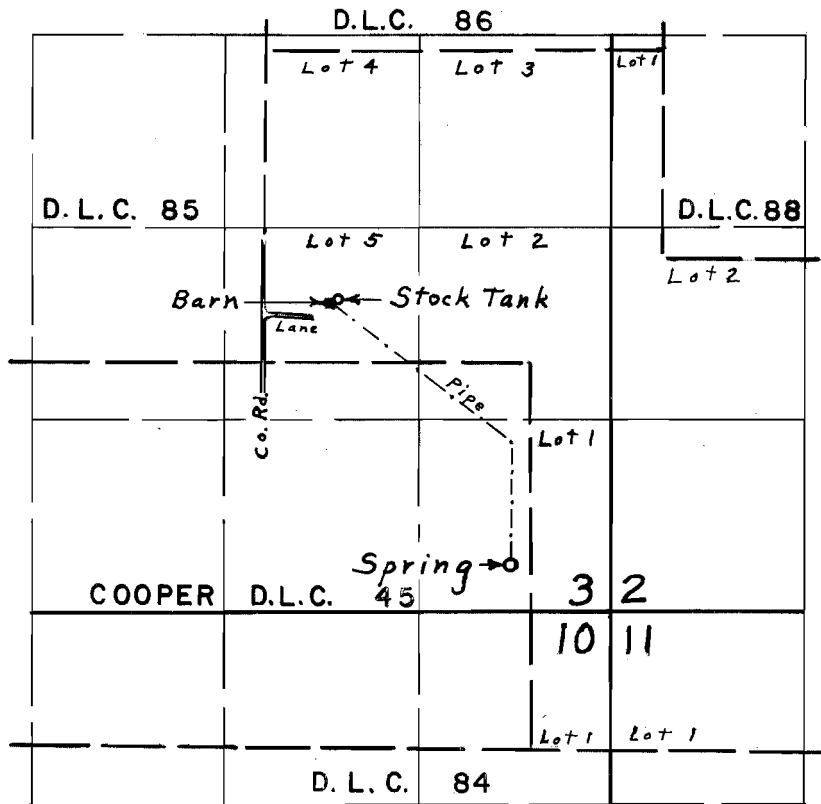

Spring located 1380' S. & 130' W. from N.E. Cor. Cooper D.L.C. 45

FINAL PROOF SURVEY UNDER

Application No. 50240 Permit No. 37542
IN NAME OF

RICHARD D. SNYDER

Surveyed Aug. 1, 1975, by L. E. Gould