


T. 4 S. R. 4 W. W.M.

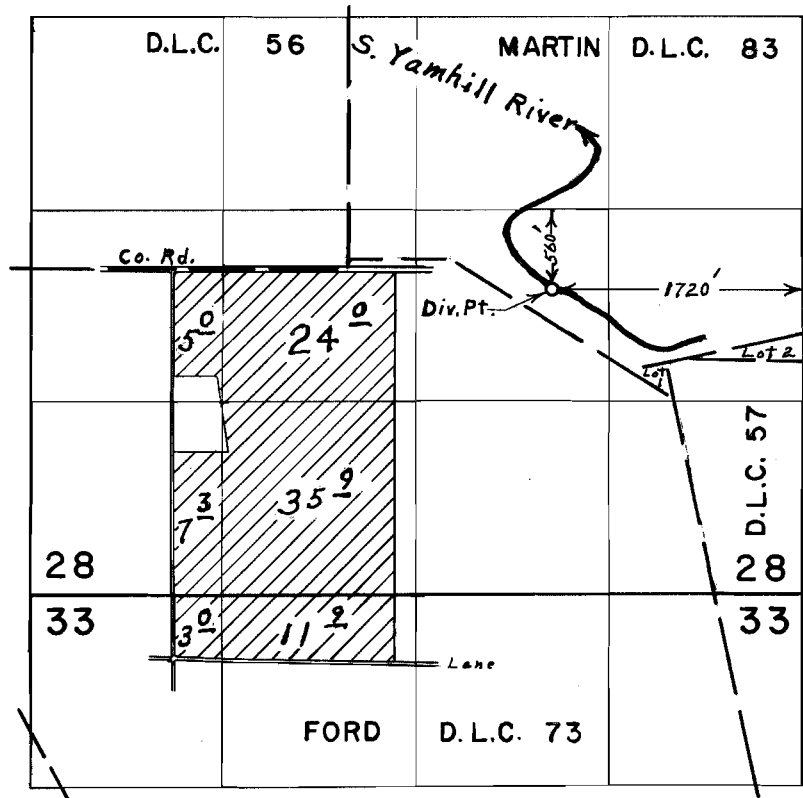

FINAL PROOF SURVEY UNDER

Application No. 49980 Permit No. 37593
IN NAME OF

HERBERT C. COLEMAN

Surveyed Aug. 7, 1975, by L. E. Gould