


T. 4 S. R. 5 W. W.M.

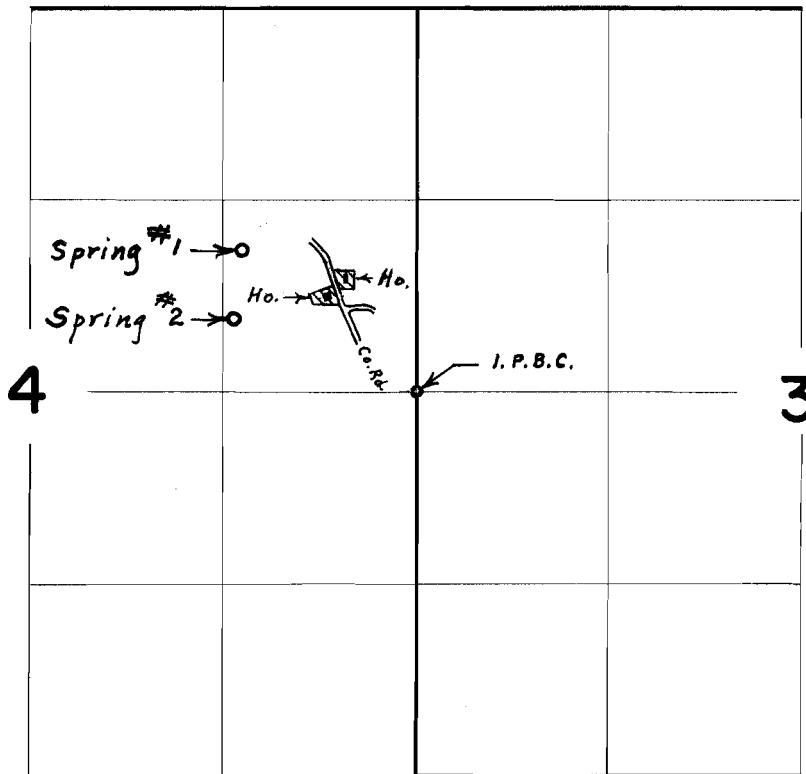

Springs located: #1, 980' N. & 1200' W.; #2, 500' N. & 1250' W., both from E. $\frac{1}{4}$ Cor. Sec. 4.

FINAL PROOF SURVEY
UNDER

Application No. 50781 Permit No. 37759
IN NAME OF

J. A. ROOPER

Surveyed Aug. 6, 1975, by L. E. Gould