


T.3S., R.4W., W.M.

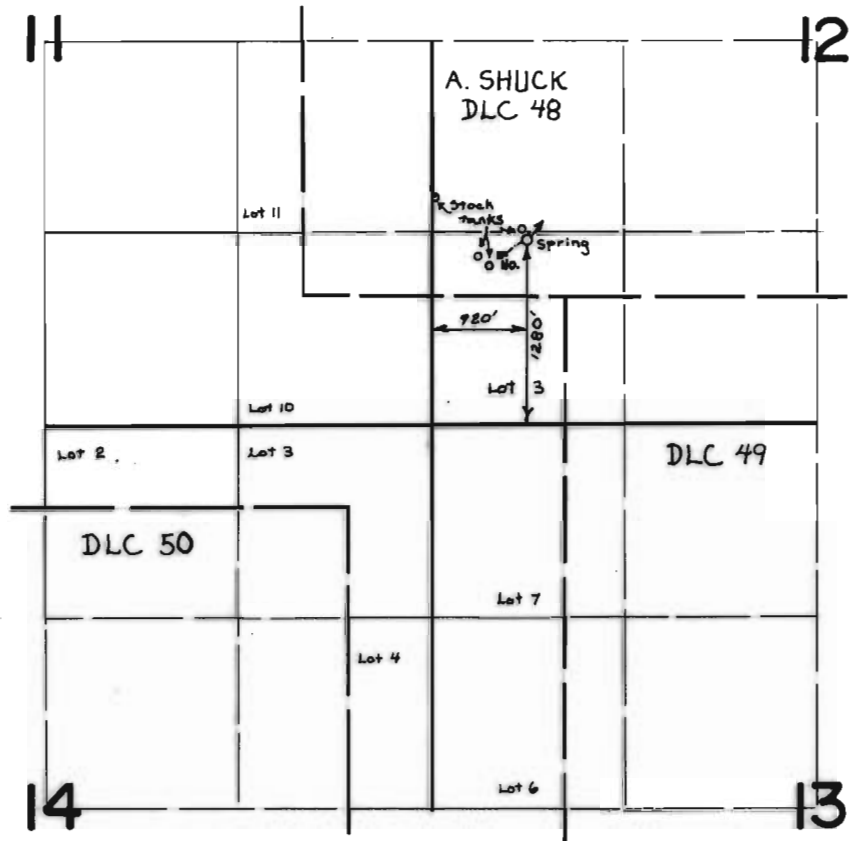

**FINAL PROOF SURVEY**  
UNDER.

Application No. 51744 Permit No. 37791  
IN NAME OF

MARVIN L. WILLIAMS

Surveyed AUG. 2 1976, by L. H. NUNN