


# T.5S.R.4W.W.M.

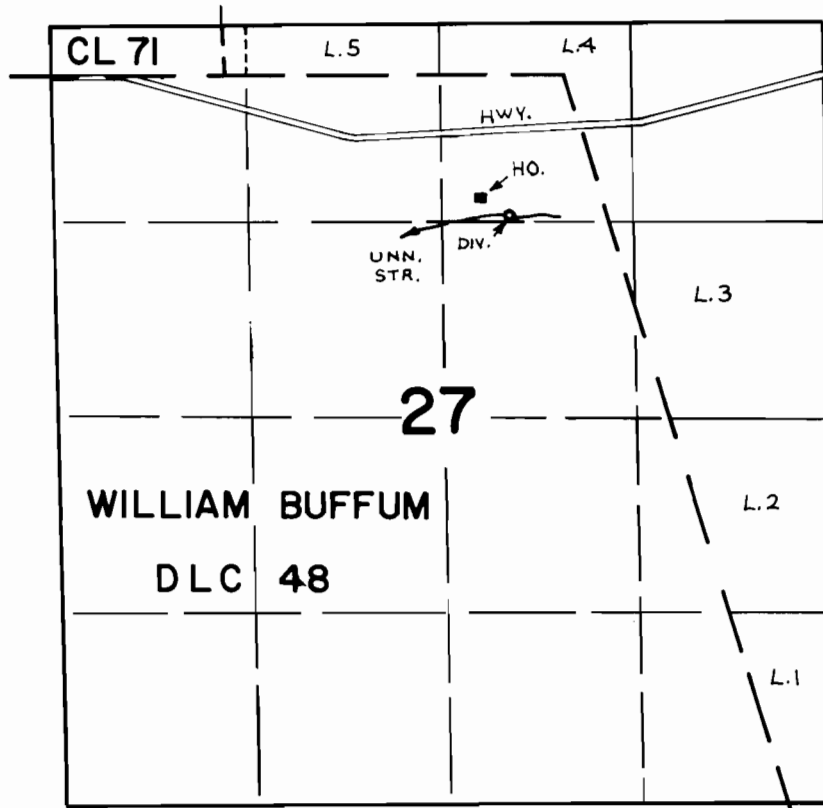

DIV. LOC. - 960' S. & 370' W. FROM N.E. COR. BUFFUM DLC 48

## FINAL PROOF SURVEY UNDER

Application No. 53124 Permit No. 38602  
IN NAME OF

MARIE A. BENJAMIN

Surveyed June 1, 1976, by R.G. Mucken