


T.21S. R.384W. W.M.

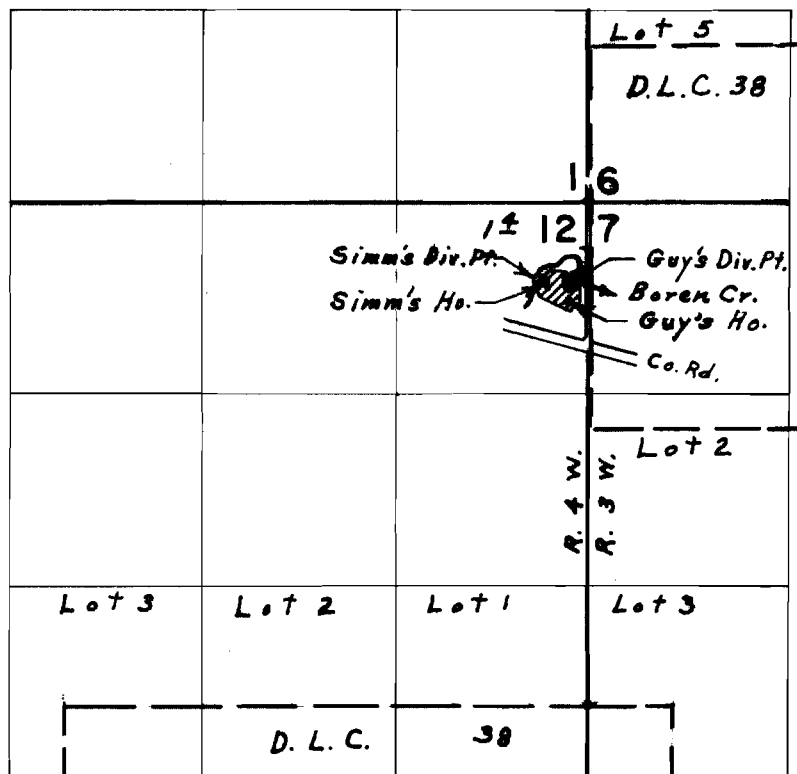

Div. Pts. located: Simms, 520' S. & 350' W., Guy's, 580' S. & 180' W., both from N.E. Corner Section 12.

FINAL PROOF SURVEY
UNDER

Application No. 46379 Permit No. 34639

IN NAME OF
LARRY H. & TRUDIE E. SIMMS &
ROLAND M. & NINA B. GUY

Surveyed March 25, 1975, by L. E. Gould