


T.19S. R.1W. W. M.

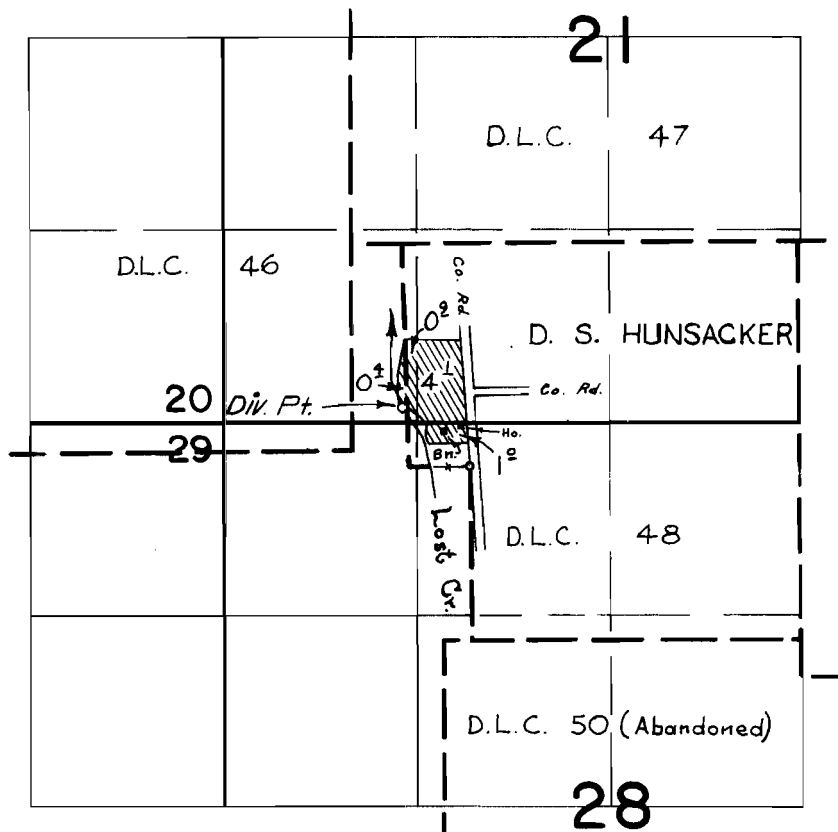

DIV. PT. LOC.: 410' N. & 450' W. FROM W. INT. ELL COR. HUNSACKER
D.L.C. 48

FINAL PROOF SURVEY
UNDER

Application No. 47010 Permit No. 35169
IN NAME OF

WILLIAM G. LEONARD

Surveyed April 17, 1975, by R. Mucken