


T.22S. R.384W. W.M.

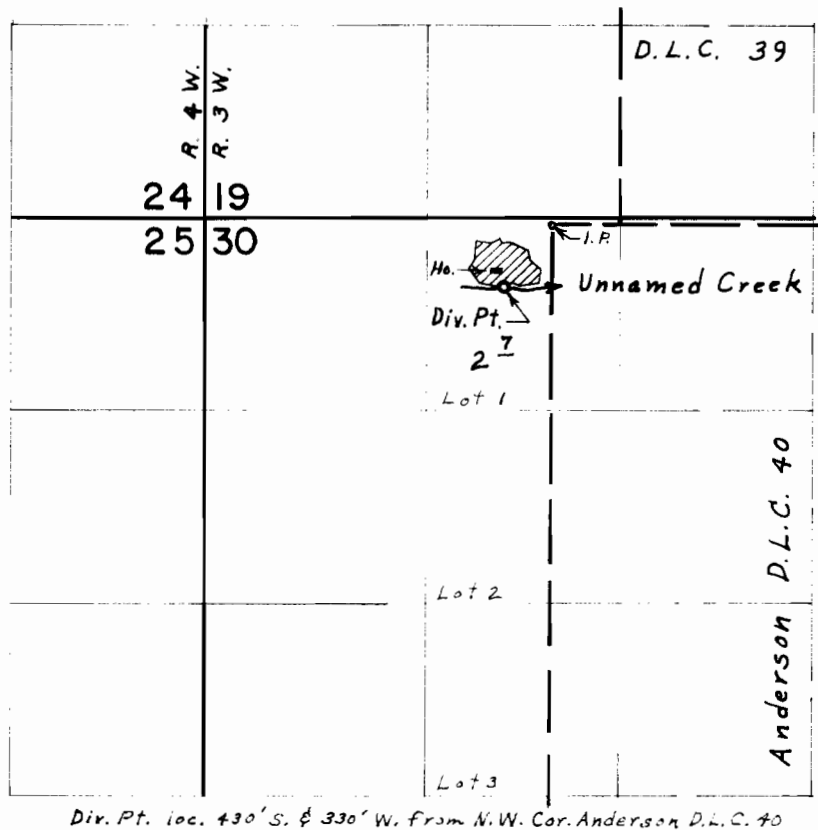

Div. Pt. loc. 430' S. & 330' W. from N.W. Cor. Anderson D.L.C. 40

FINAL PROOF SURVEY
UNDER

Application No. 47886 Permit No. 35883
IN NAME OF

WAYNE BERGGREN

Surveyed March 27 1975, by L. E. Gould