


T.21S. R.283W. W.M.

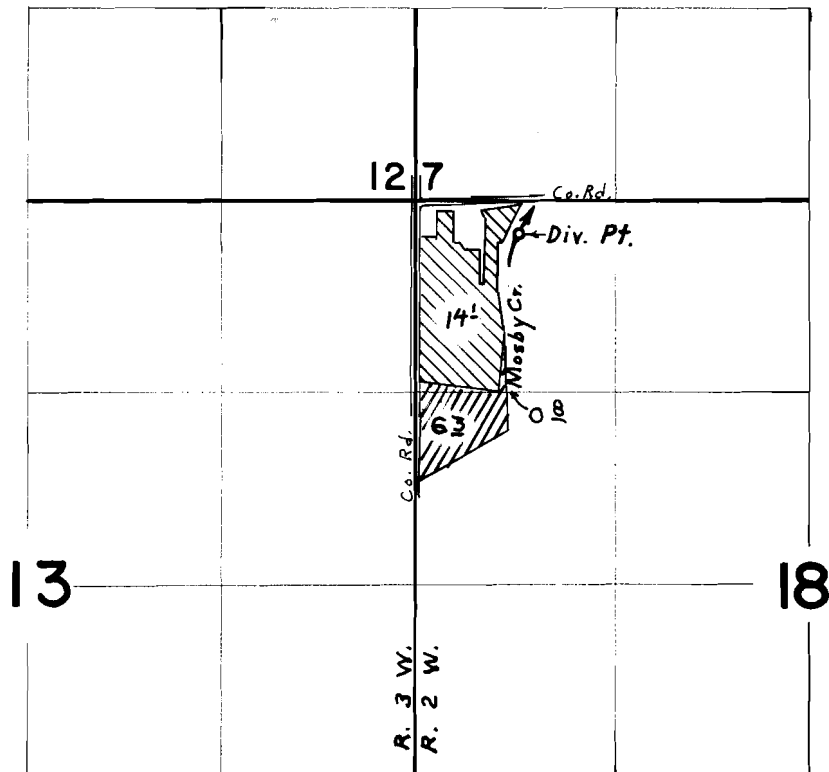

Div. Pt. Loc. 220' S. & 710' E. from N.W. Cor. Sec. 18

FINAL PROOF SURVEY
UNDER



PERMIT 36585



PERMIT 42991

57172 42991
Application No. 48800 Permit No. 36585
IN NAME OF

GEORGIA PACIFIC CORPORATION

AUG 30 84 R. PAGTER
Surveyed March 26, 1975, by L. E. Gould

41039 - 378 - 146 PGT