


T. 20 S. R. 3 W. W.M.

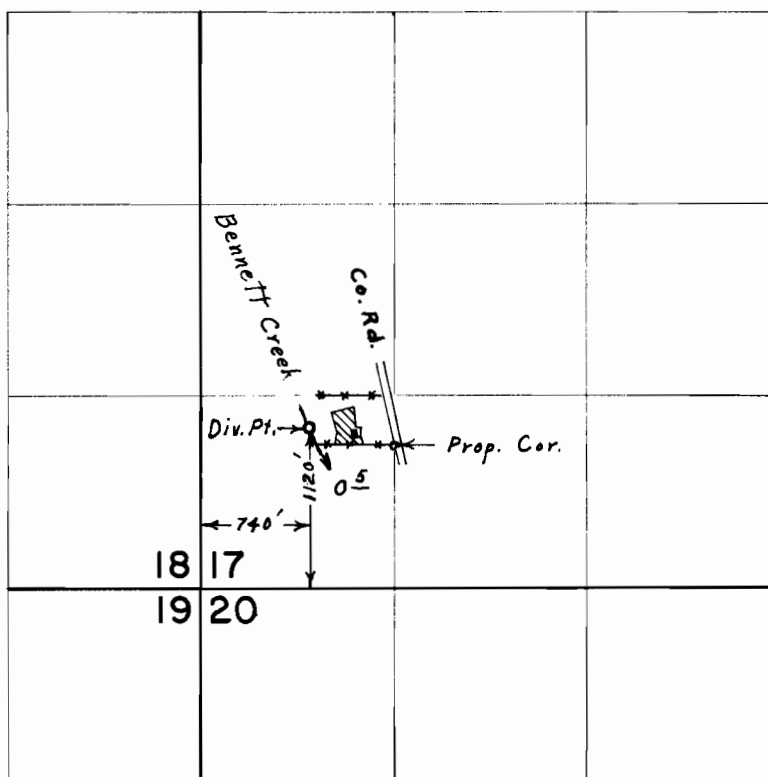

FINAL PROOF SURVEY
UNDER

Application No. 48987 Permit No. 36675
IN NAME OF

HANS K. WAGENER

Surveyed March 25, 1975, by L. E. Gould