


T.18S. R.1W. W. M.

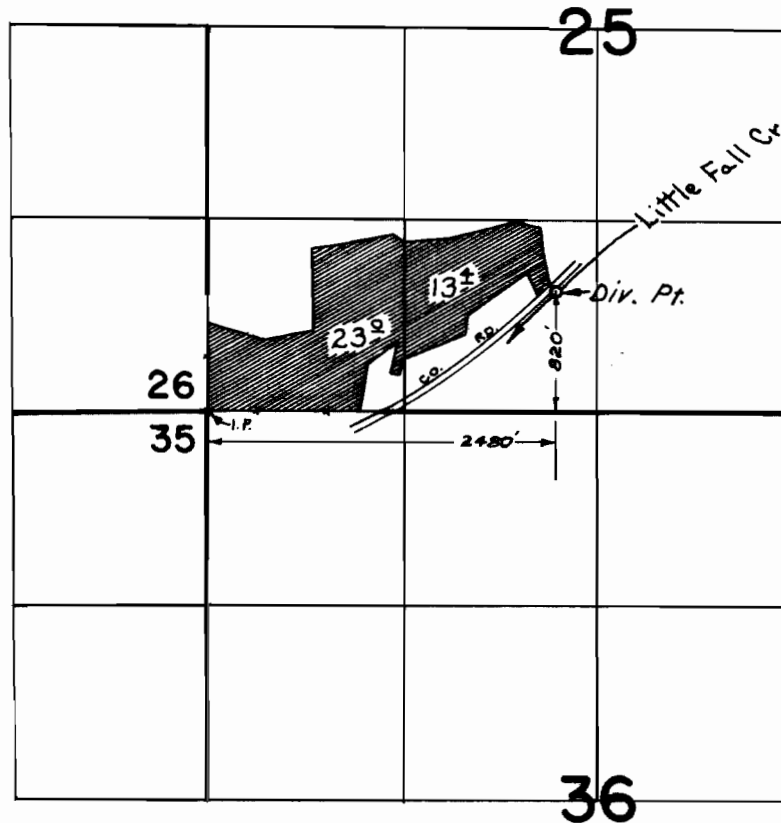

FINAL PROOF SURVEY
UNDER

Application No. 49203 Permit No. 36882
IN NAME OF

SPRAGUE'S INC.

Surveyed April 23, 1975, by R. Mucken