


T.39S. R.5W. W.M.

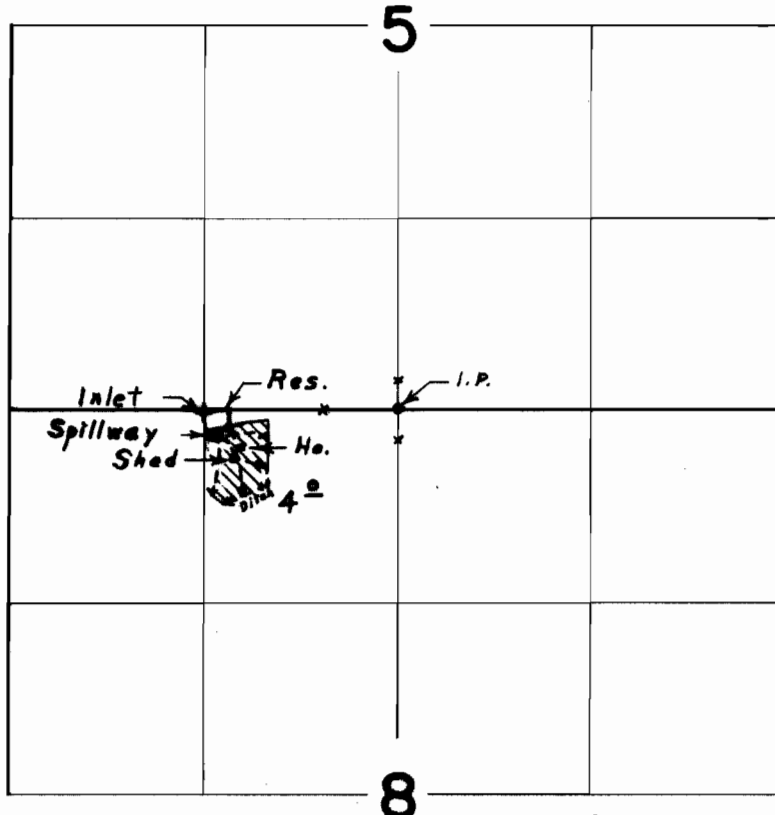

Div. Pt. located 120' S. & 1200' W. from N. $\frac{1}{4}$ Cor. Sec. 8

FINAL PROOF SURVEY
UNDER

R-49376 R-6008
Application No. 49377 Permit No. 37011
IN NAME OF

ALLEN P. CARRE

Surveyed Sept. 15, 1975, by L. E. Gould