


T.14S., R.5W., W.M.

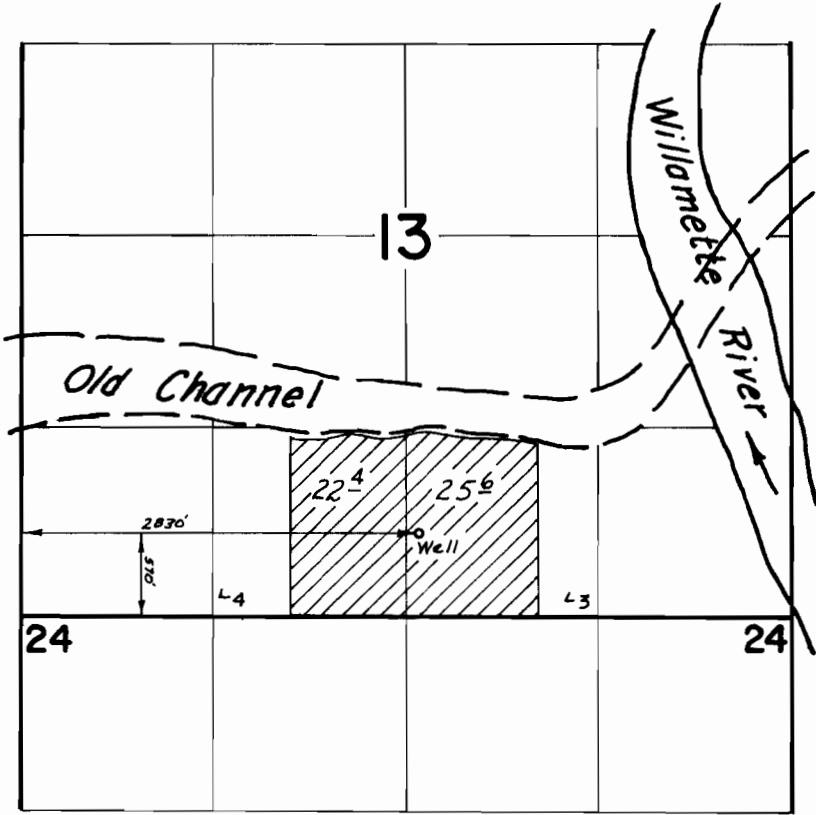

FINAL PROOF SURVEY
UNDER

Application No. G-4578 Permit No. G-4308
IN NAME OF

DELBERT C. PITCHER

Surveyed Aug. 14 1975, by D. Norby