


T.14S., R.6W., W.M.

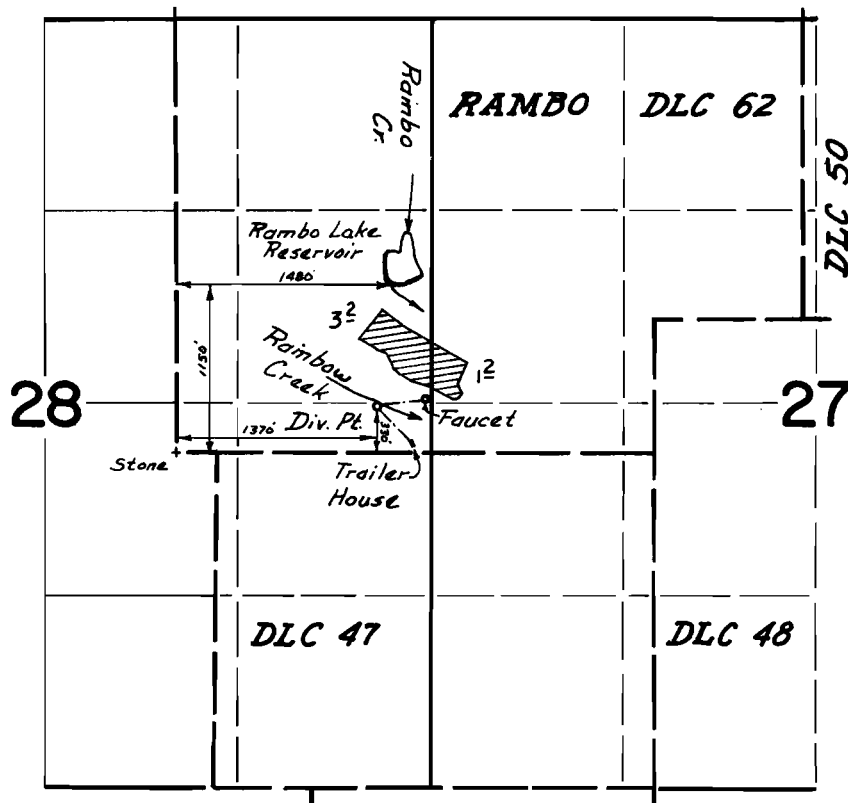

FINAL PROOF SURVEY
UNDER

R-45874 R-5399
Application No. 44810 Permit No. 34016
IN NAME OF

THE CHURCH OF JESUS CHRIST OF LATTER-DAY SAINTS

Surveyed Aug. 6 1975, by D. Norby