


T.5 S. R.1 W. W.M.

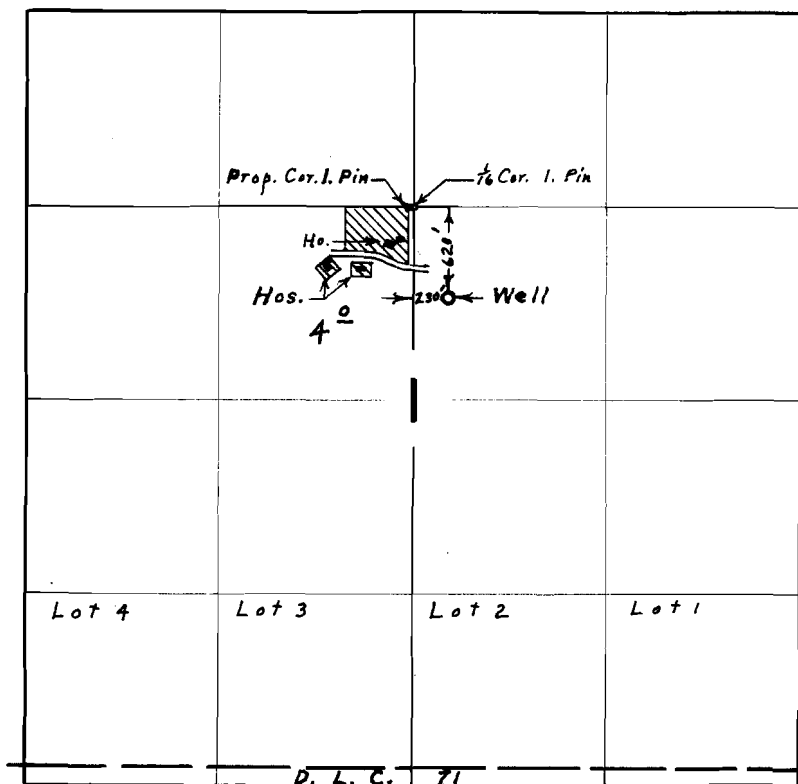

FINAL PROOF SURVEY UNDER

Application No. G-4497. Permit No. G-4239
IN NAME OF

.....JOSEPH LOKTEFF.....

Surveyed June 17 1974, by L. E. Gould.....