


# T. 6 S. R. 1 E. W. M.

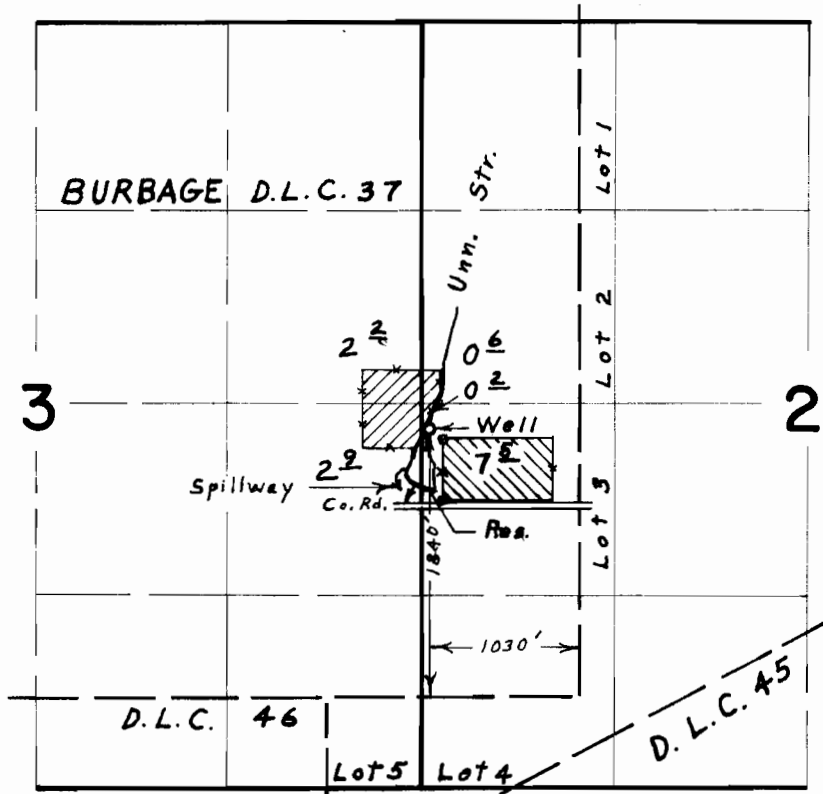

Primary   
 Supplemental 

## FINAL PROOF SURVEY

UNDER

Application No. G-5028 Permit No. G-4733

IN NAME OF

FRANK GEHRMAN

Surveyed May 28, 1975, by L. E. Gould