


T.4N. R.1&2W. W.M.

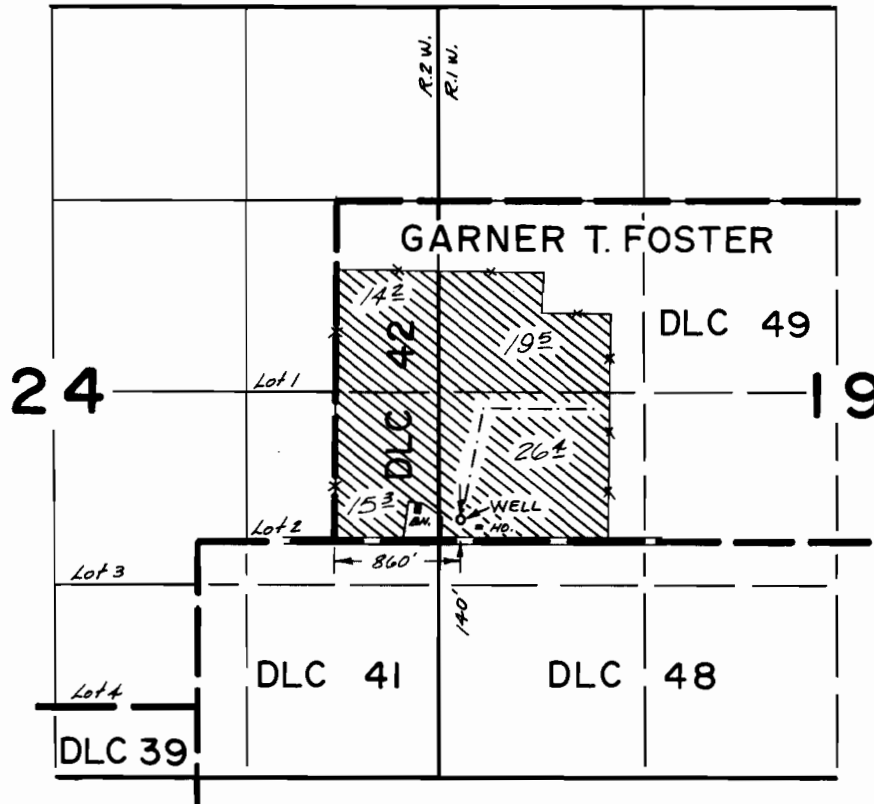

FINAL PROOF SURVEY
UNDER

Application No. G.3791 Permit No. G.3477
IN NAME OF

PAUL T. GORIN

Surveyed JUNE 11 1975, by R.G. MUCKEN