


# T. 4 N. R. 4 W. W.M.

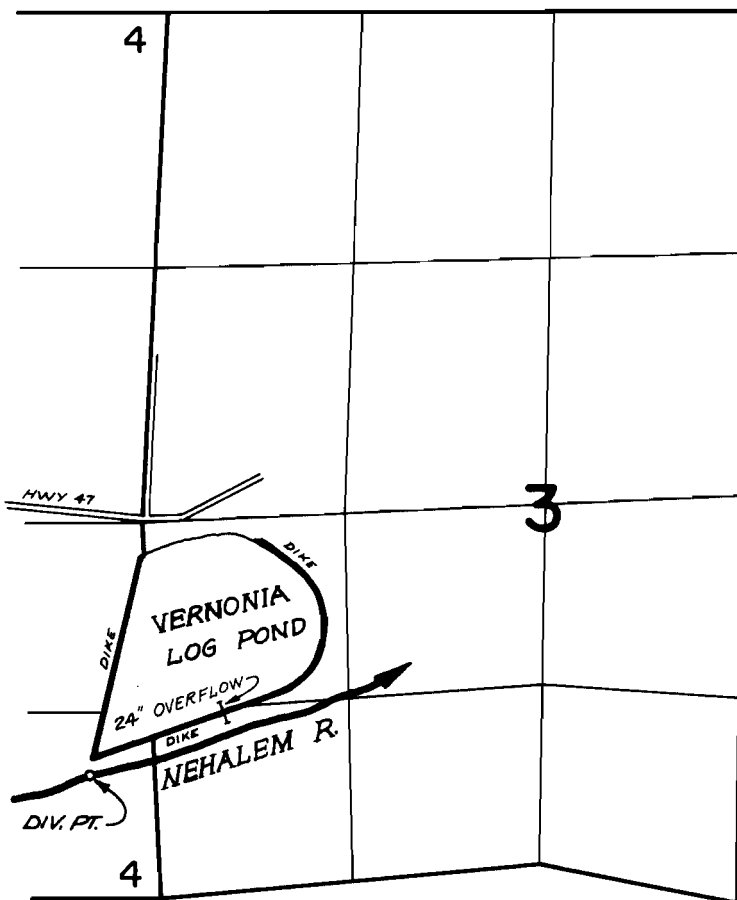

RIV. DIV. PT., 1740' S. & 350' W. FROM E. 1/4 COR. SEC. 4  
 RES. DIV. PT., 1330' S. & 550' E. FROM W. 1/4 COR. SEC. 3

## FINAL PROOF SURVEY UNDER

Application No. <sup>45974</sup>~~R.45973~~ Permit No. <sup>34420</sup>~~R.5481~~  
 IN NAME OF

OREGON STATE GAME COMMISSION

Surveyed AUG. 13 1975, by R. G. MUCKEN