


T. 4 N. R. 4 W. W.M.

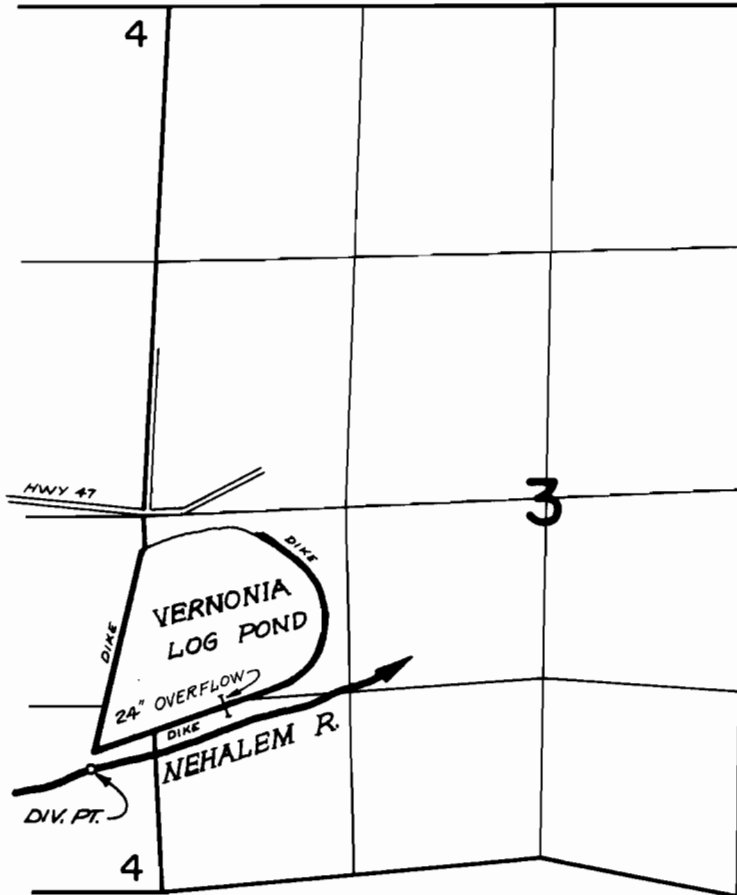

RIV. DIV. PT., 1740'S. & 350' W. FROM E. 1/4 COR. SEC. 4
RES. DIV. PT., 1330'S. & 550' E. FROM W 1/4 COR. SEC. 3

FINAL PROOF SURVEY UNDER

45974 34420
Application No. *R.45973* Permit No. *R.5481*
IN NAME OF

OREGON STATE GAME COMMISSION

Surveyed *AUG. 13.* 1975, by *R.G. MUCKEN*