


T. 4. N. R. 2 & 3 W. W.M.

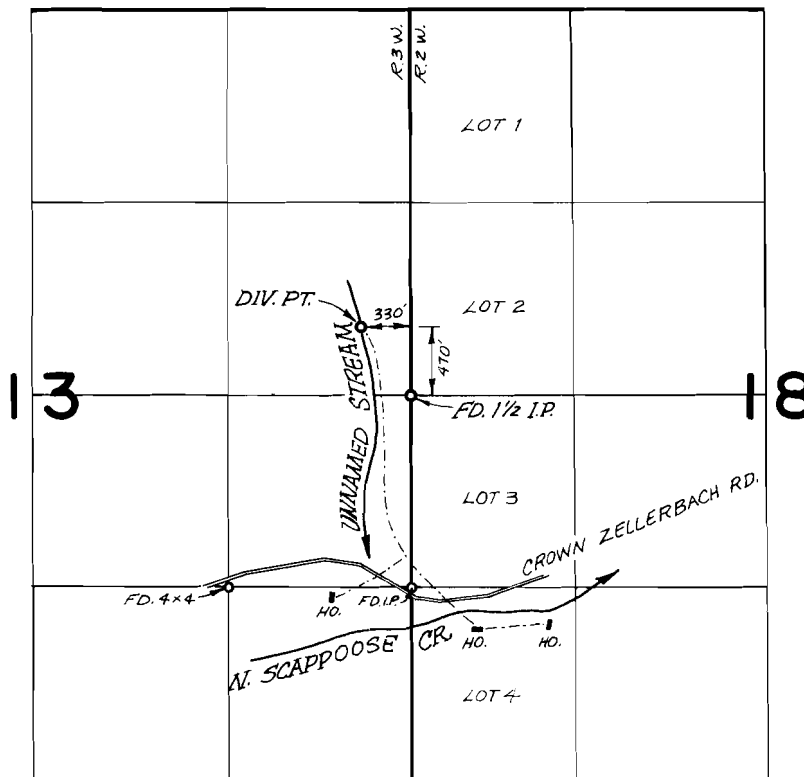

FINAL PROOF SURVEY
UNDER

Application No. 47314 Permit No. 35447
IN NAME OF
THERON F. GAHR
JAMES E. & CAROL SUE CUMMINS
ESTATE OF THERON C. GAHR
Surveyed JUNE 11, 1975, by R.G. MUCKEN