


T.29&30S.R.11W.W.M.

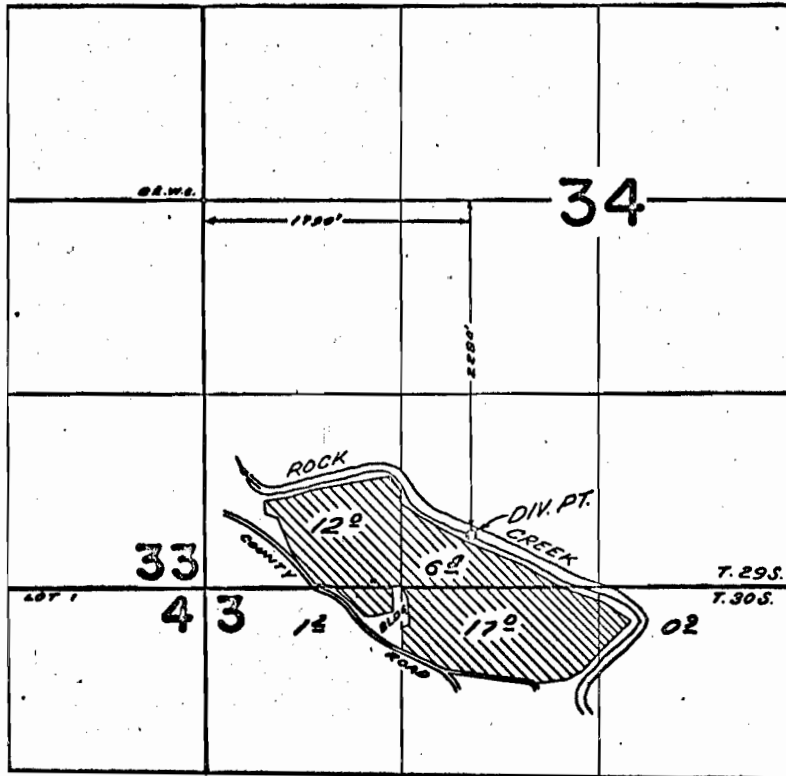

Application No. 47824
Permit No. 35850

FINAL PROOF SURVEY
UNDER

Application No. 39612 Permit No. 29329
IN NAME OF

ROBERT C. GEANEY

Surveyed SEP. 10 1969, by D. BUELL