


T.29 S. R.12 W. W.M.

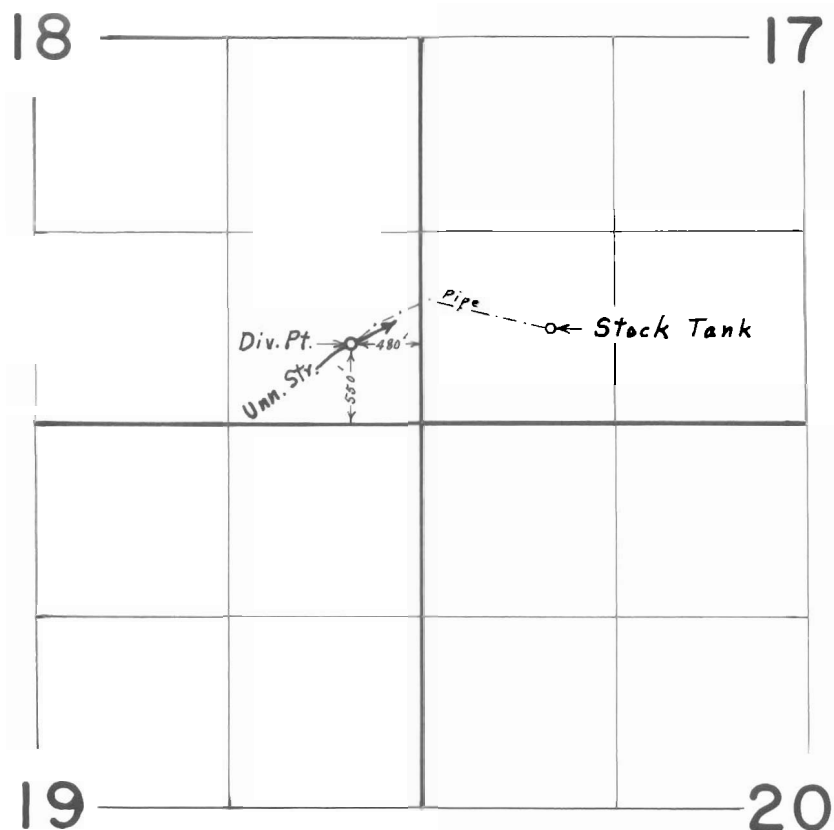

FINAL PROOF SURVEY
UNDER

Application No. 49524... Permit No. 37369...
IN NAME OF

LELAND H. & SYLVIA DARLENE BARKLOW

Surveyed Oct. 23, 1975, by L. E. Gould.