


# T.4S.,R.13W.,W.M.

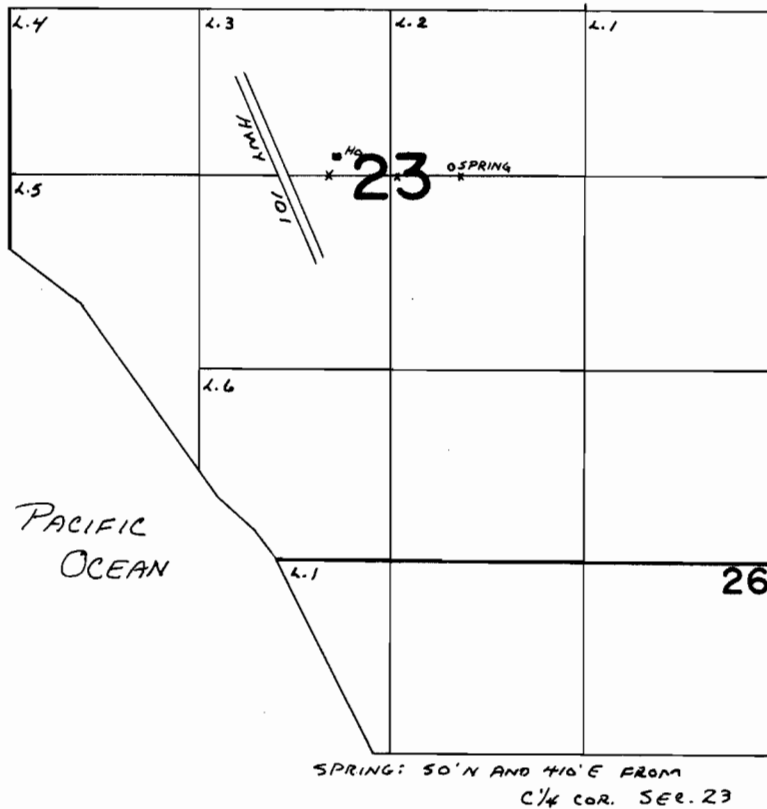

## FINAL PROOF SURVEY UNDER

Application No. 37751 Permit No. 28136  
IN NAME OF

GEORGE HANN

Surveyed JULY 18 1975, by L. T. U.