


T.4S.,R.13W.,W.M.

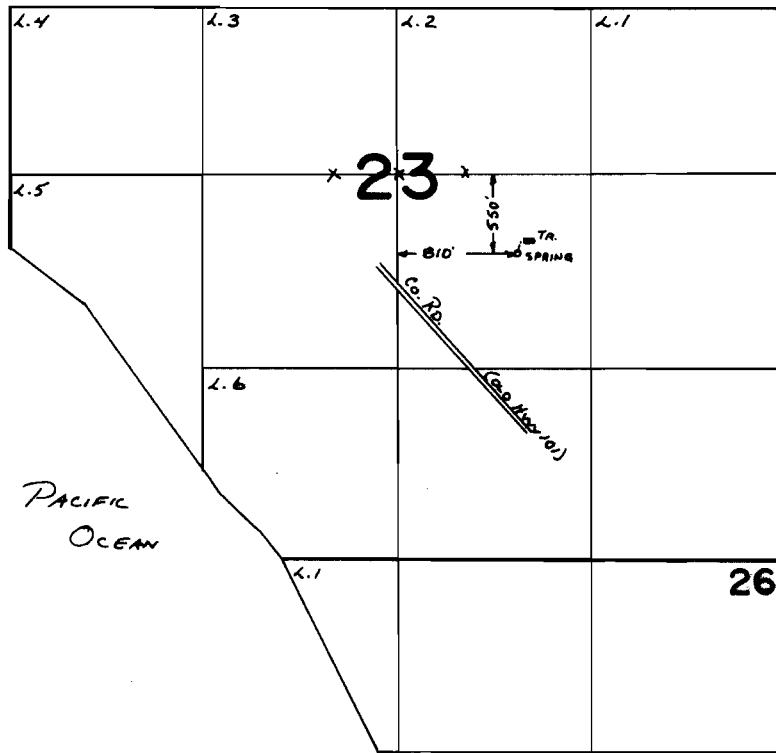

FINAL PROOF SURVEY UNDER

Application No. 46457 Permit No. 34708
IN NAME OF

CHARLES S. MARSTERS

Surveyed July 18 1975, by S. T. H.