


T.40S. R.14W. W.M.

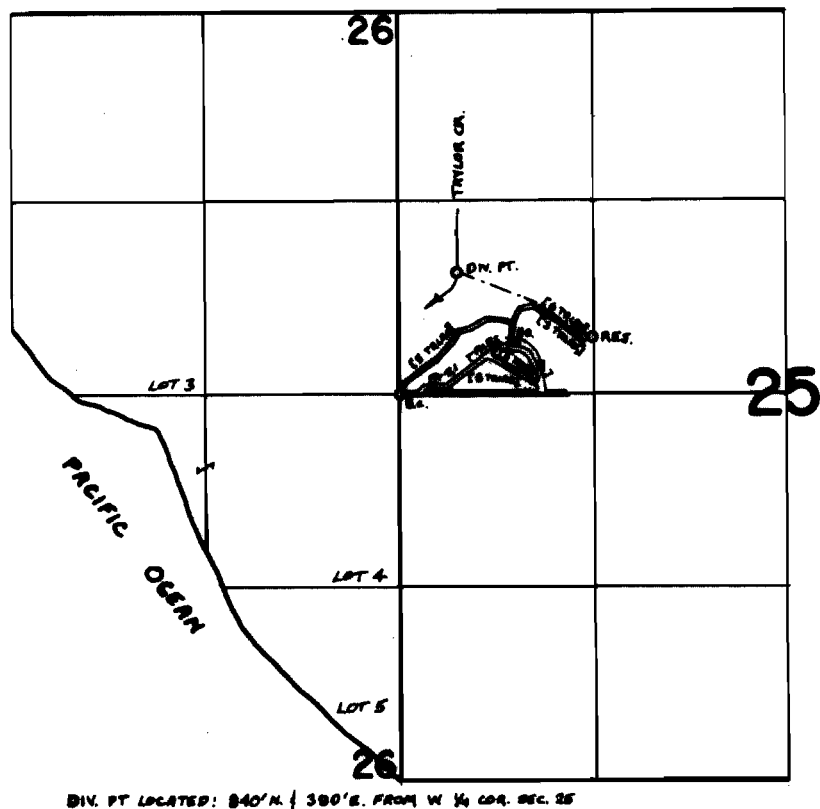

FINAL PROOF SURVEY

UNDER

Application No. 47145 Permit No. 35298
IN NAME OF

NILS EDIN

Surveyed JULY 17 1975, by L. TOLL.....