


T.28S.,R.6W.,W.M.

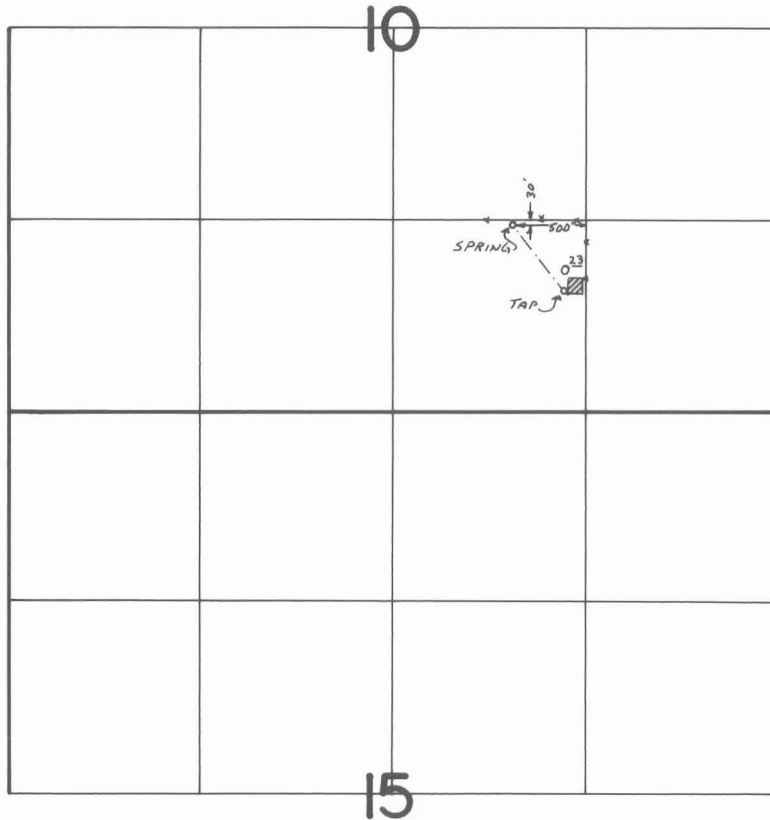

FINAL PROOF SURVEY
UNDER

Application No. 49483 Permit No. 37064
IN NAME OF

ARMANDE LE BLANC

Surveyed July 21, 1975, by L. E. Gougeon