


T. 23 S. R. 7 W. W. M.

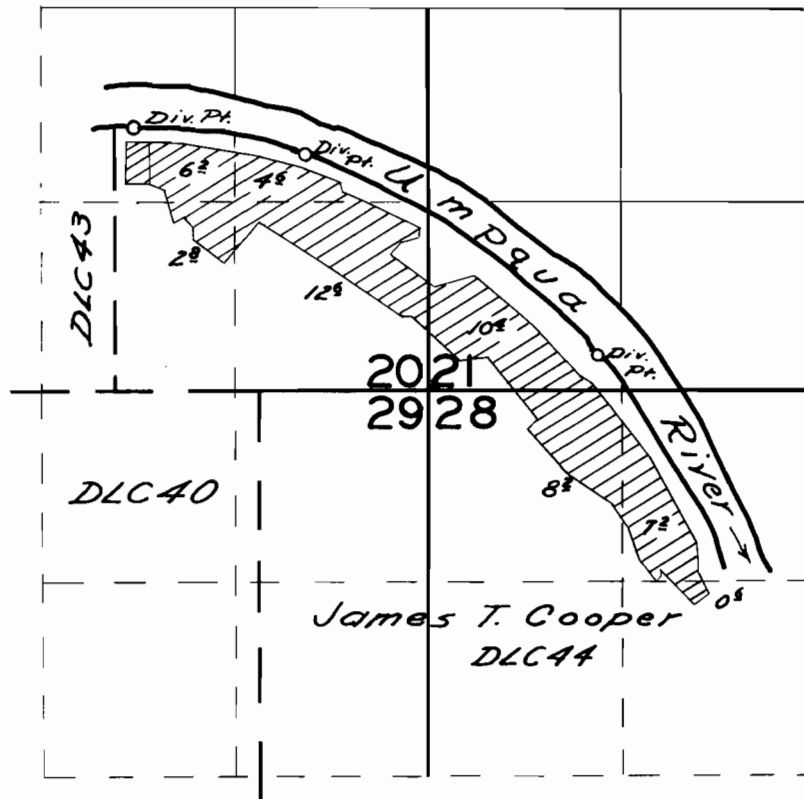

FINAL PROOF SURVEY
UNDER

Application No. 25701, Permit No. 20139
IN NAME OF

P. W. George

Surveyed July 1, 1956 by *C. O. Bartels*