


T.18S. R.31E. W. M.

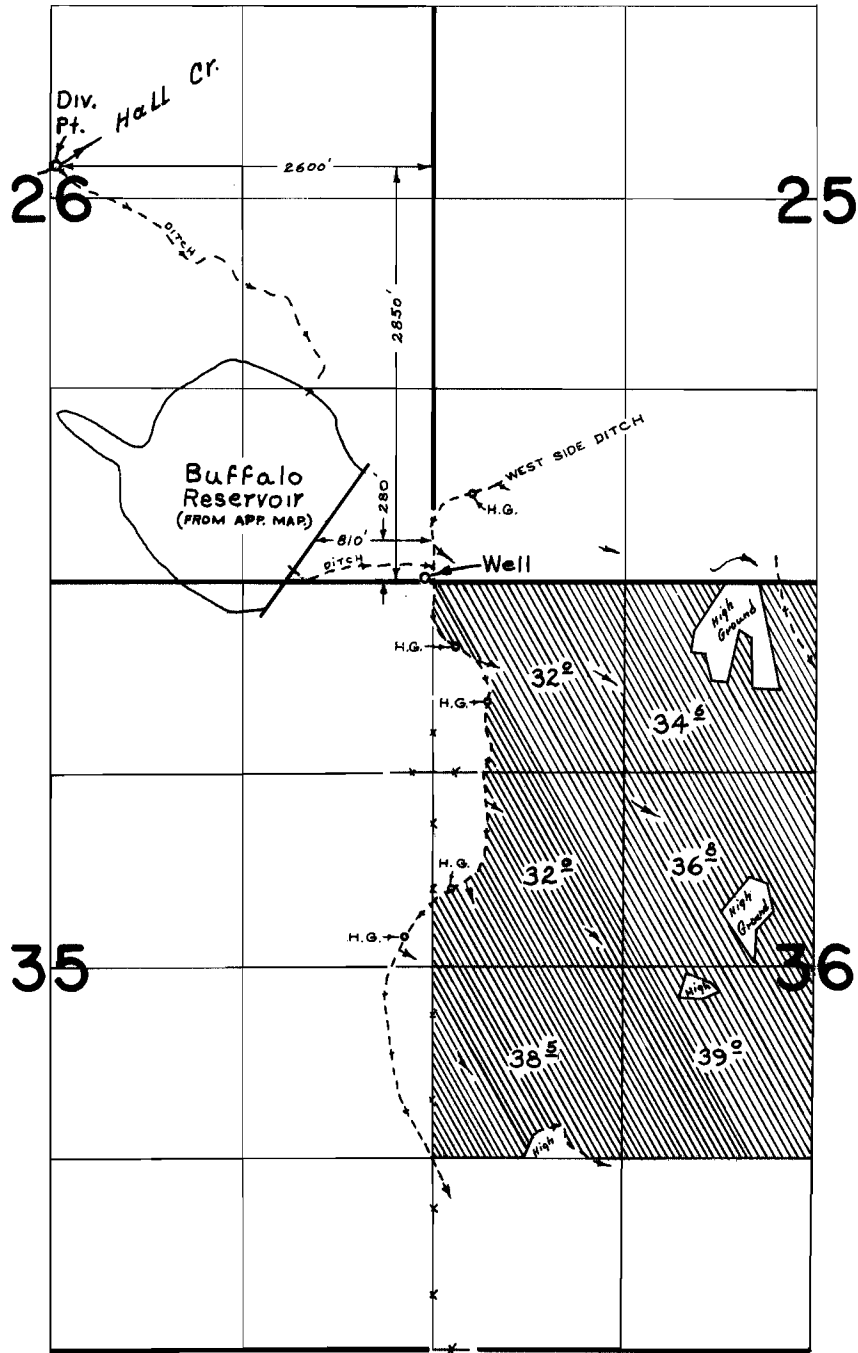

FINAL PROOF SURVEY
UNDER

Application No. 38194 Permit No. 28501
IN NAME OF

CLIFFORD L. WOLFSWINKEL

Surveyed JUNE 24 & 25, 1975, by R. MUCKEN