



P-30286

P6717 ?
POU ?

T.13S., R.26E., W.M.

44468

See Marked
up P 30286
map

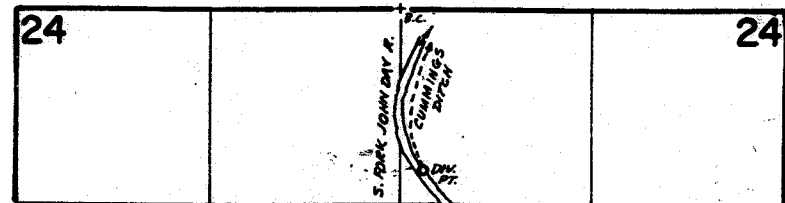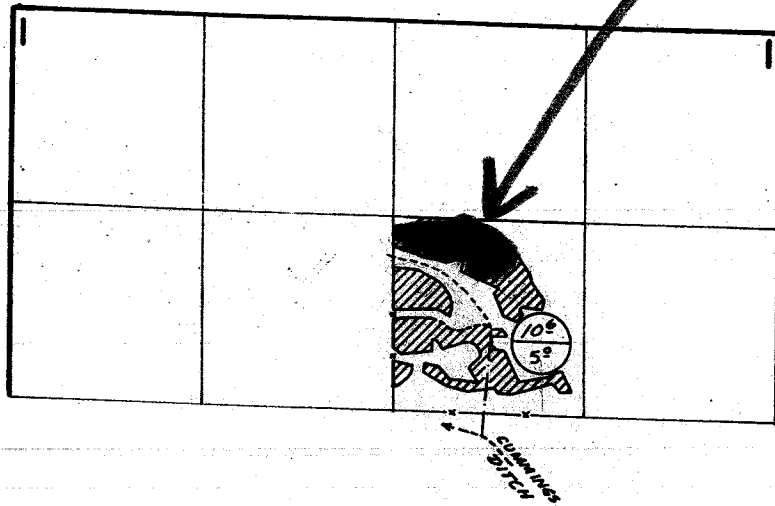

DIV. PT. LOC: 1090'S & 160' E FROM N 1/4 COR. SEC. 24

THIS APPLICATION
CERT. 10101

FINAL PROOF SURVEY UNDER

Application No. 40654 Permit No. 30286
 IN NAME OF
BERNARD A. STREETER
 Surveyed June 25 1975, by D. Norby