


T.13S.,R.31E.,W.M.

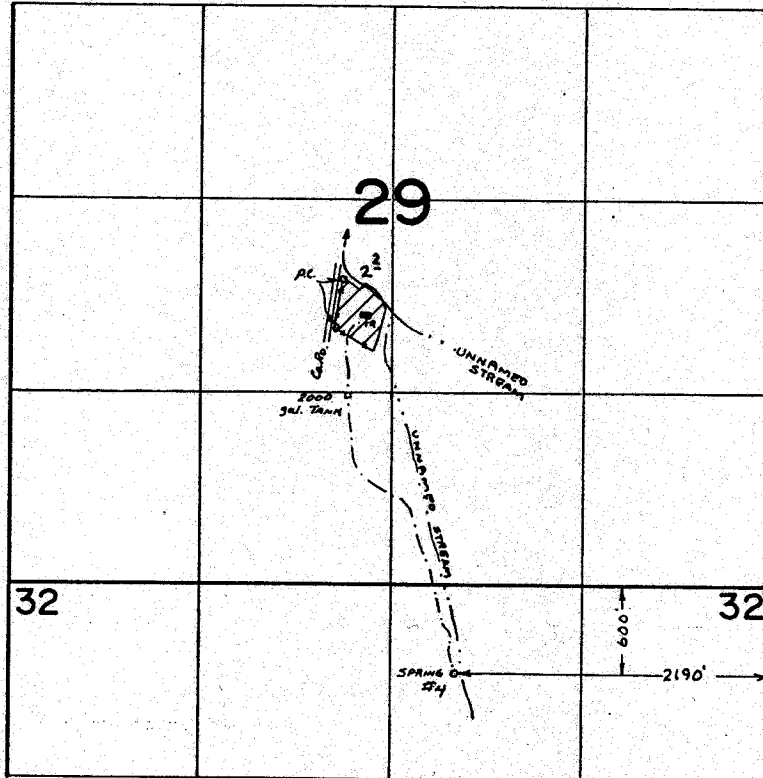

FINAL PROOF SURVEY UNDER

Application No. 47166 Permit No. 35311
IN NAME OF

AUGUST H. STEVENSON

Surveyed Aug. 23 1975, by L. Toll