


P-30312

C-44470
R-4560

T.13S., R.26E., W.M.

C-47506

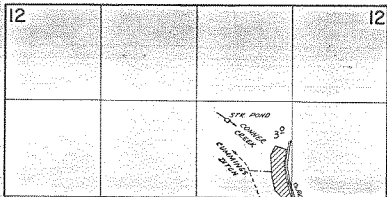

POND LOC: 1040' N & 460' E FROM CENTER SEC. 12



DITCH LOC: 1090' S & 160' E FROM N 1/4 COR. SEC. 24

FINAL PROOF SURVEY UNDER

R-40739 R-4560
Application No. 40694 Permit No. 30312
IN NAME OF

JACK C. WRIGHT

Surveyed June 26, 1975, by D. Norby