


T.2N., R.10E., W.M.

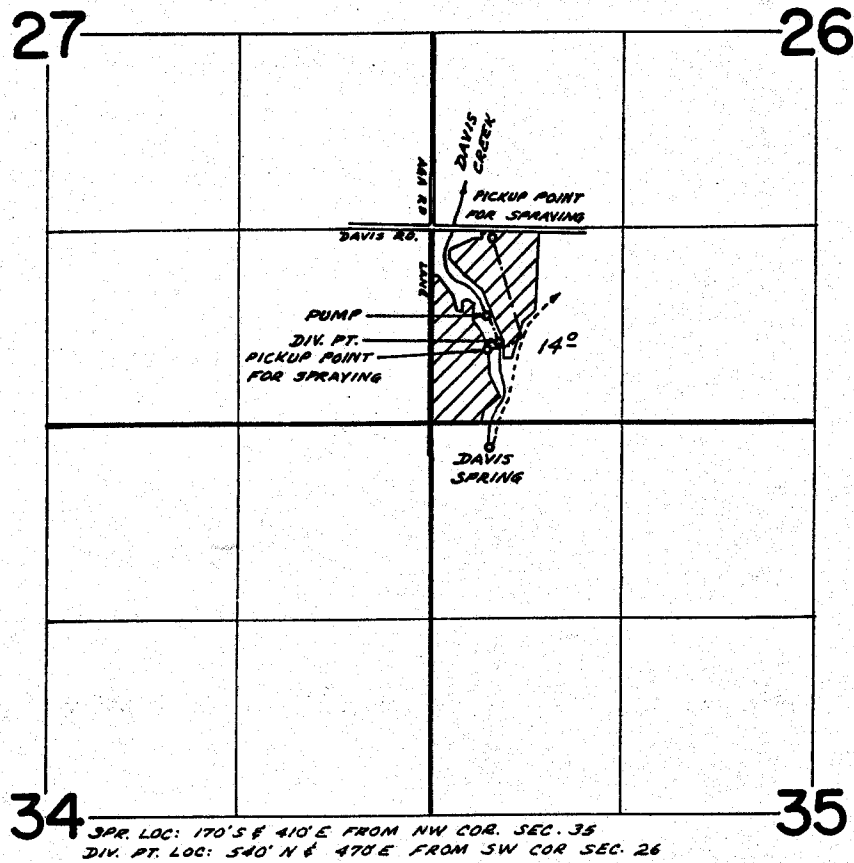

FINAL PROOF SURVEY UNDER

Application No. 46139 Permit No. 34471
IN NAME OF

JOSEPH HIGGINS

Surveyed April 17 1975, by D. Norby